


01

A.

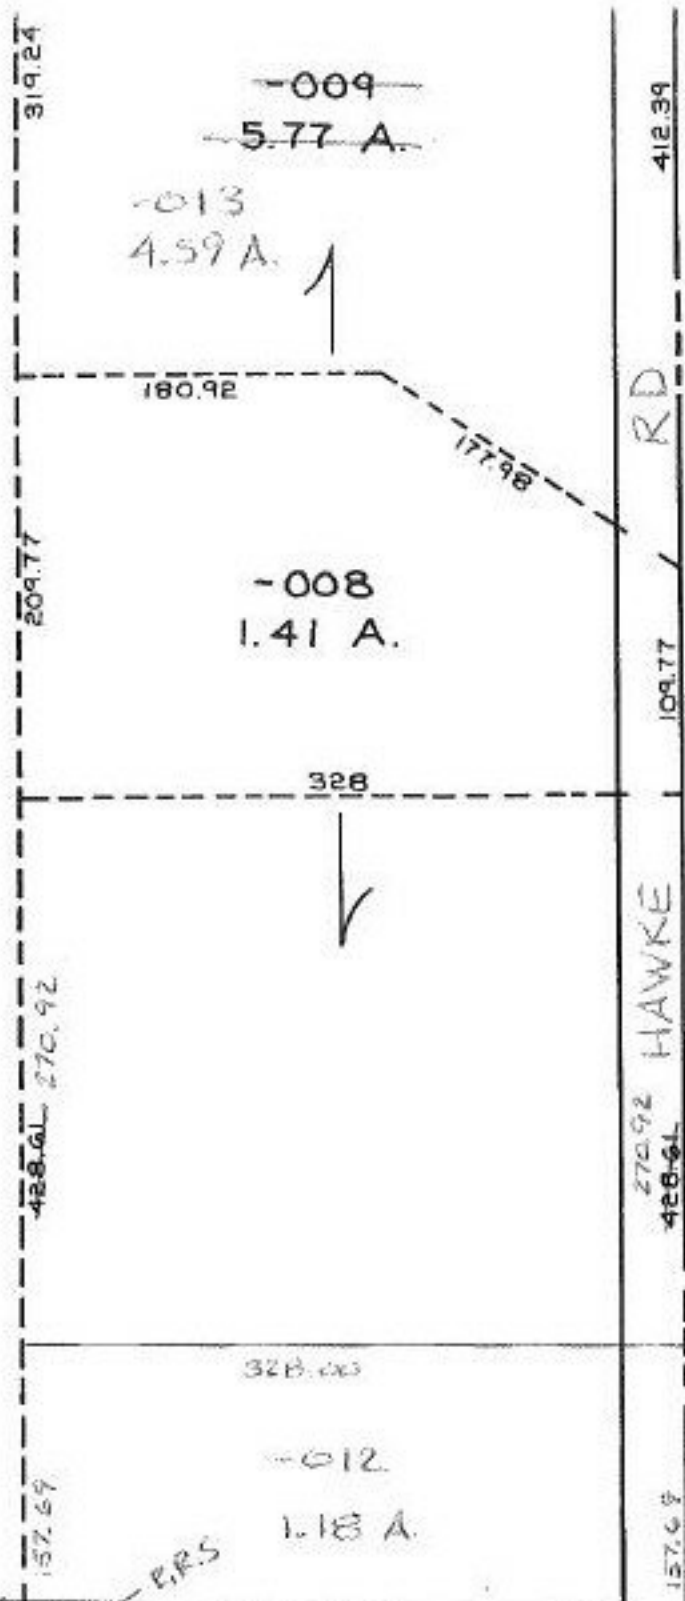

SURVEYED BY (MAP)
 WILLIAM L FOX
 C.E. N.I.E.
 PRIOR INST. - 1390/398

BROKAW

RD.

3/17/89
 #18204

113	026	75	245
112	027	85	108 -031
111	028	80	107 T. -032
110	029	80	106 -033
109	030	275	

APPROVED
 LORAIN CO.
 MAP DEPT.
 DATE 11-9-88
 PAGE 11-00-009-B
 BY T. McMan
 VOID AFTER 18204