




SEE SURVEY MAP BY
JOHN HAMILTON
CL. # 76923
PRIOR DEEDS E66/390, W05/157

~~PT. 058~~ PT. 060
~~PT. 33.03 A.~~ PT. 33.03 A.

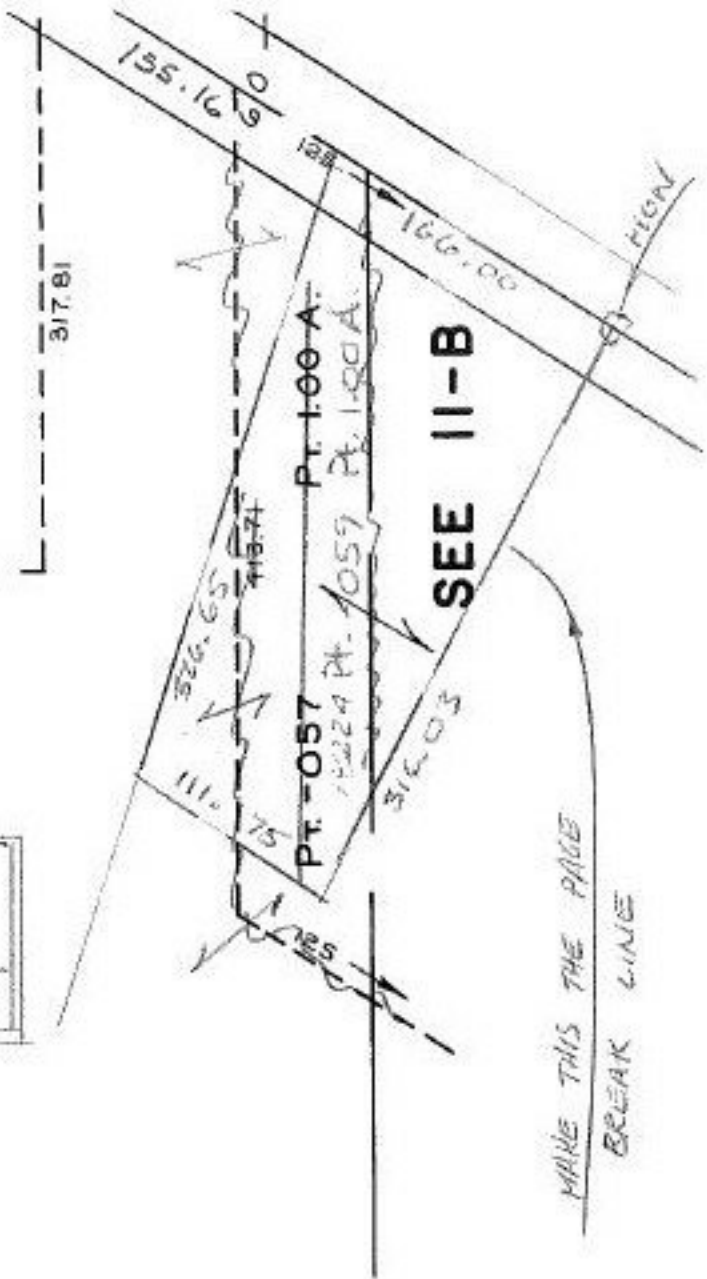

SEE II-B

MAKE THIS THE PAGE
BREAK LINE

3/17/89
#18224

APPROVED	
LORAIN CO.	
MAP DEPT.	
DATE 11-21-88	
PAGE 11-00-074 A	
BY T. McLean	
VOID AFTER	18224