


010
0.65A
011
0.64A

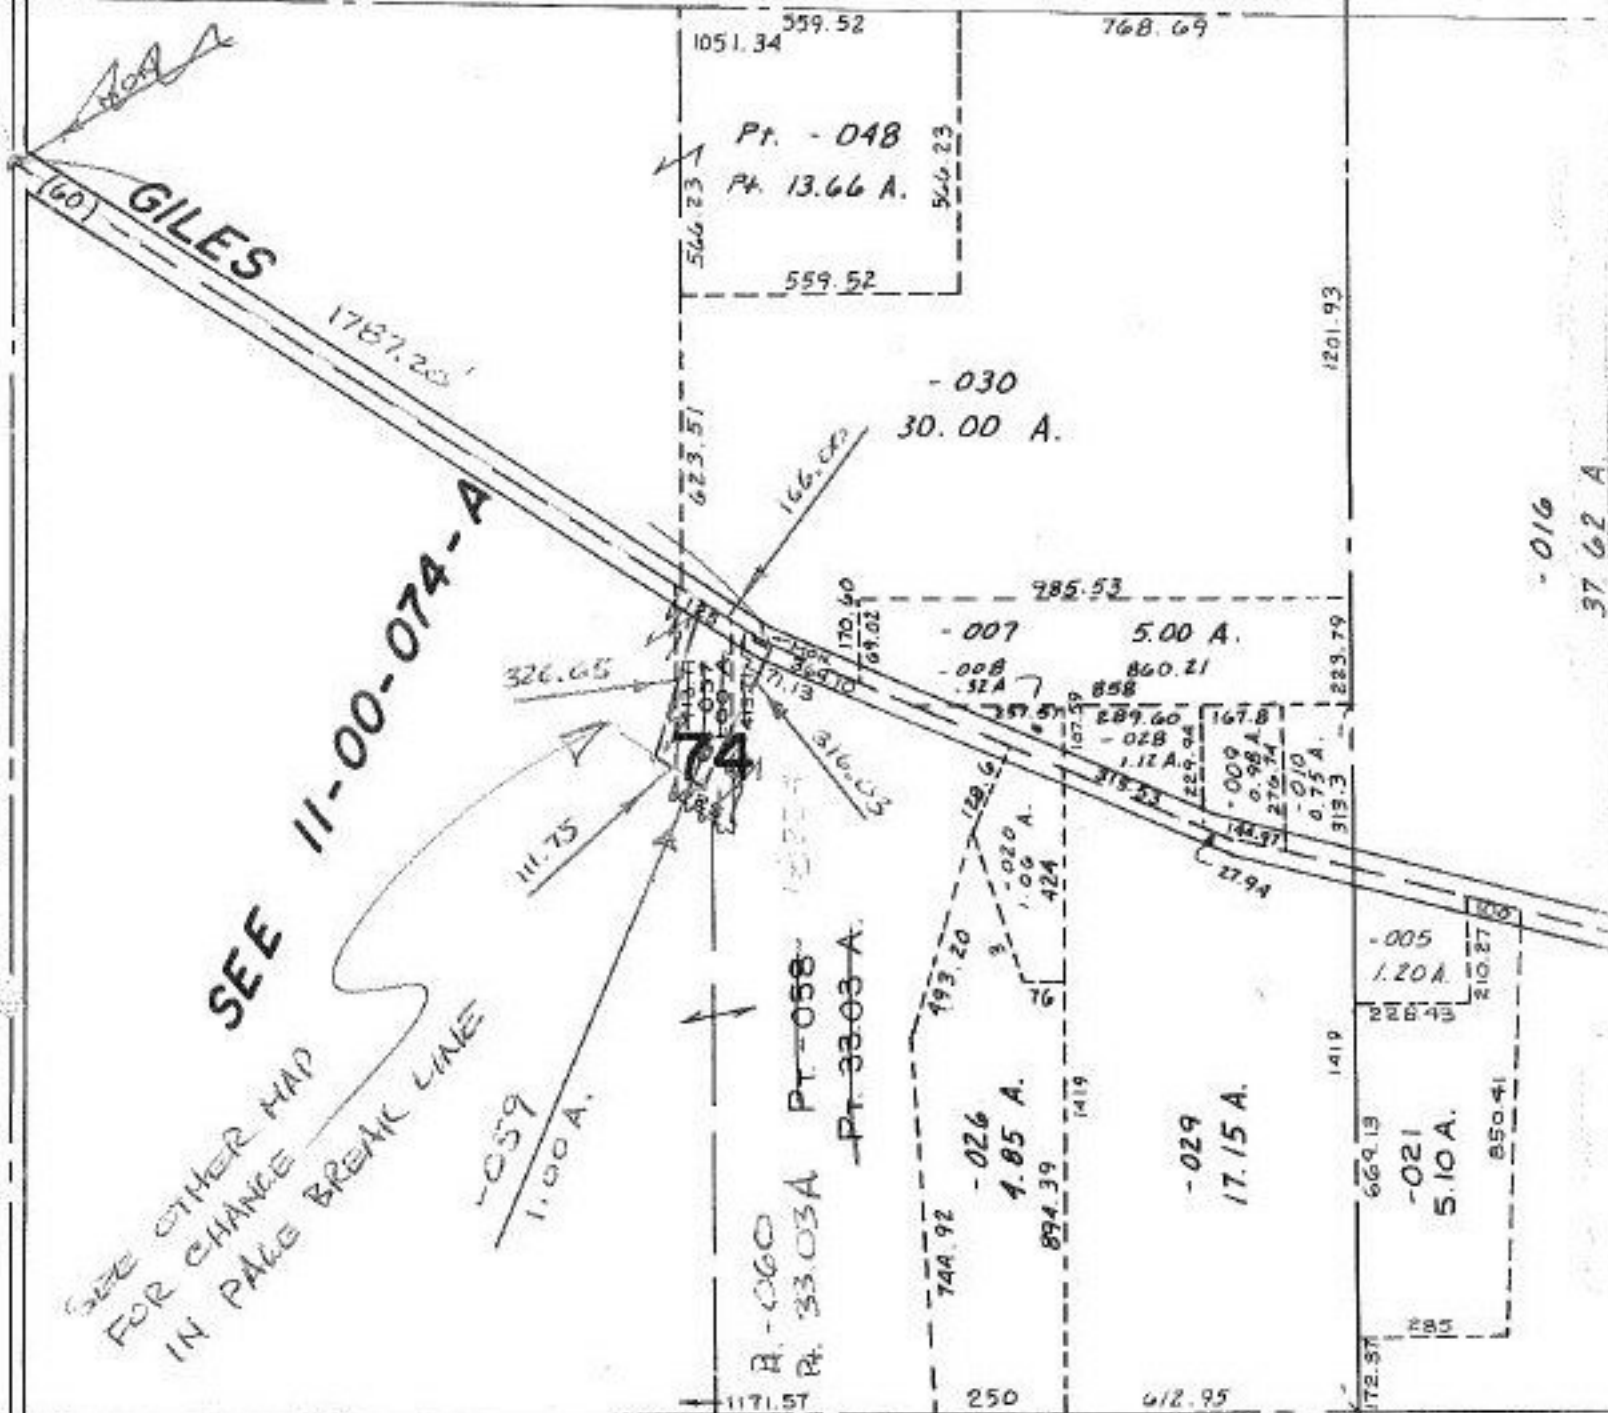

SEE OTHER MAP
FOR CHANGE
IN PAGE BREAK LINE

Pt. -001
Pt. 80.00 A.

SEE SURVEY MAP CL.
JOHN HAMILTON II

PRIOR PLOTS
860/390, 1405/457

3/17/89
#18224

APPROVED
LORAIN CO.
MAP DEPT.

DATE 11-21-88

PAGE 11-B

BY T. McVain

VOID AFTER 18224

11-00-075-B

75

-016
37.62 A.

-007
20.00 A.