

Change Parcel No. on Page 10-00-008-E



1825


APPROVED
LORAIN CO.
MAP DEPT.
DATE 6-5-68
10-00-008-E4F
BY
J. Ballard

(Signature)

D. S.
7-24-86

~~-029~~
~~34-92A.~~
-034
33.55 A.

10-013-B
-030
.08A

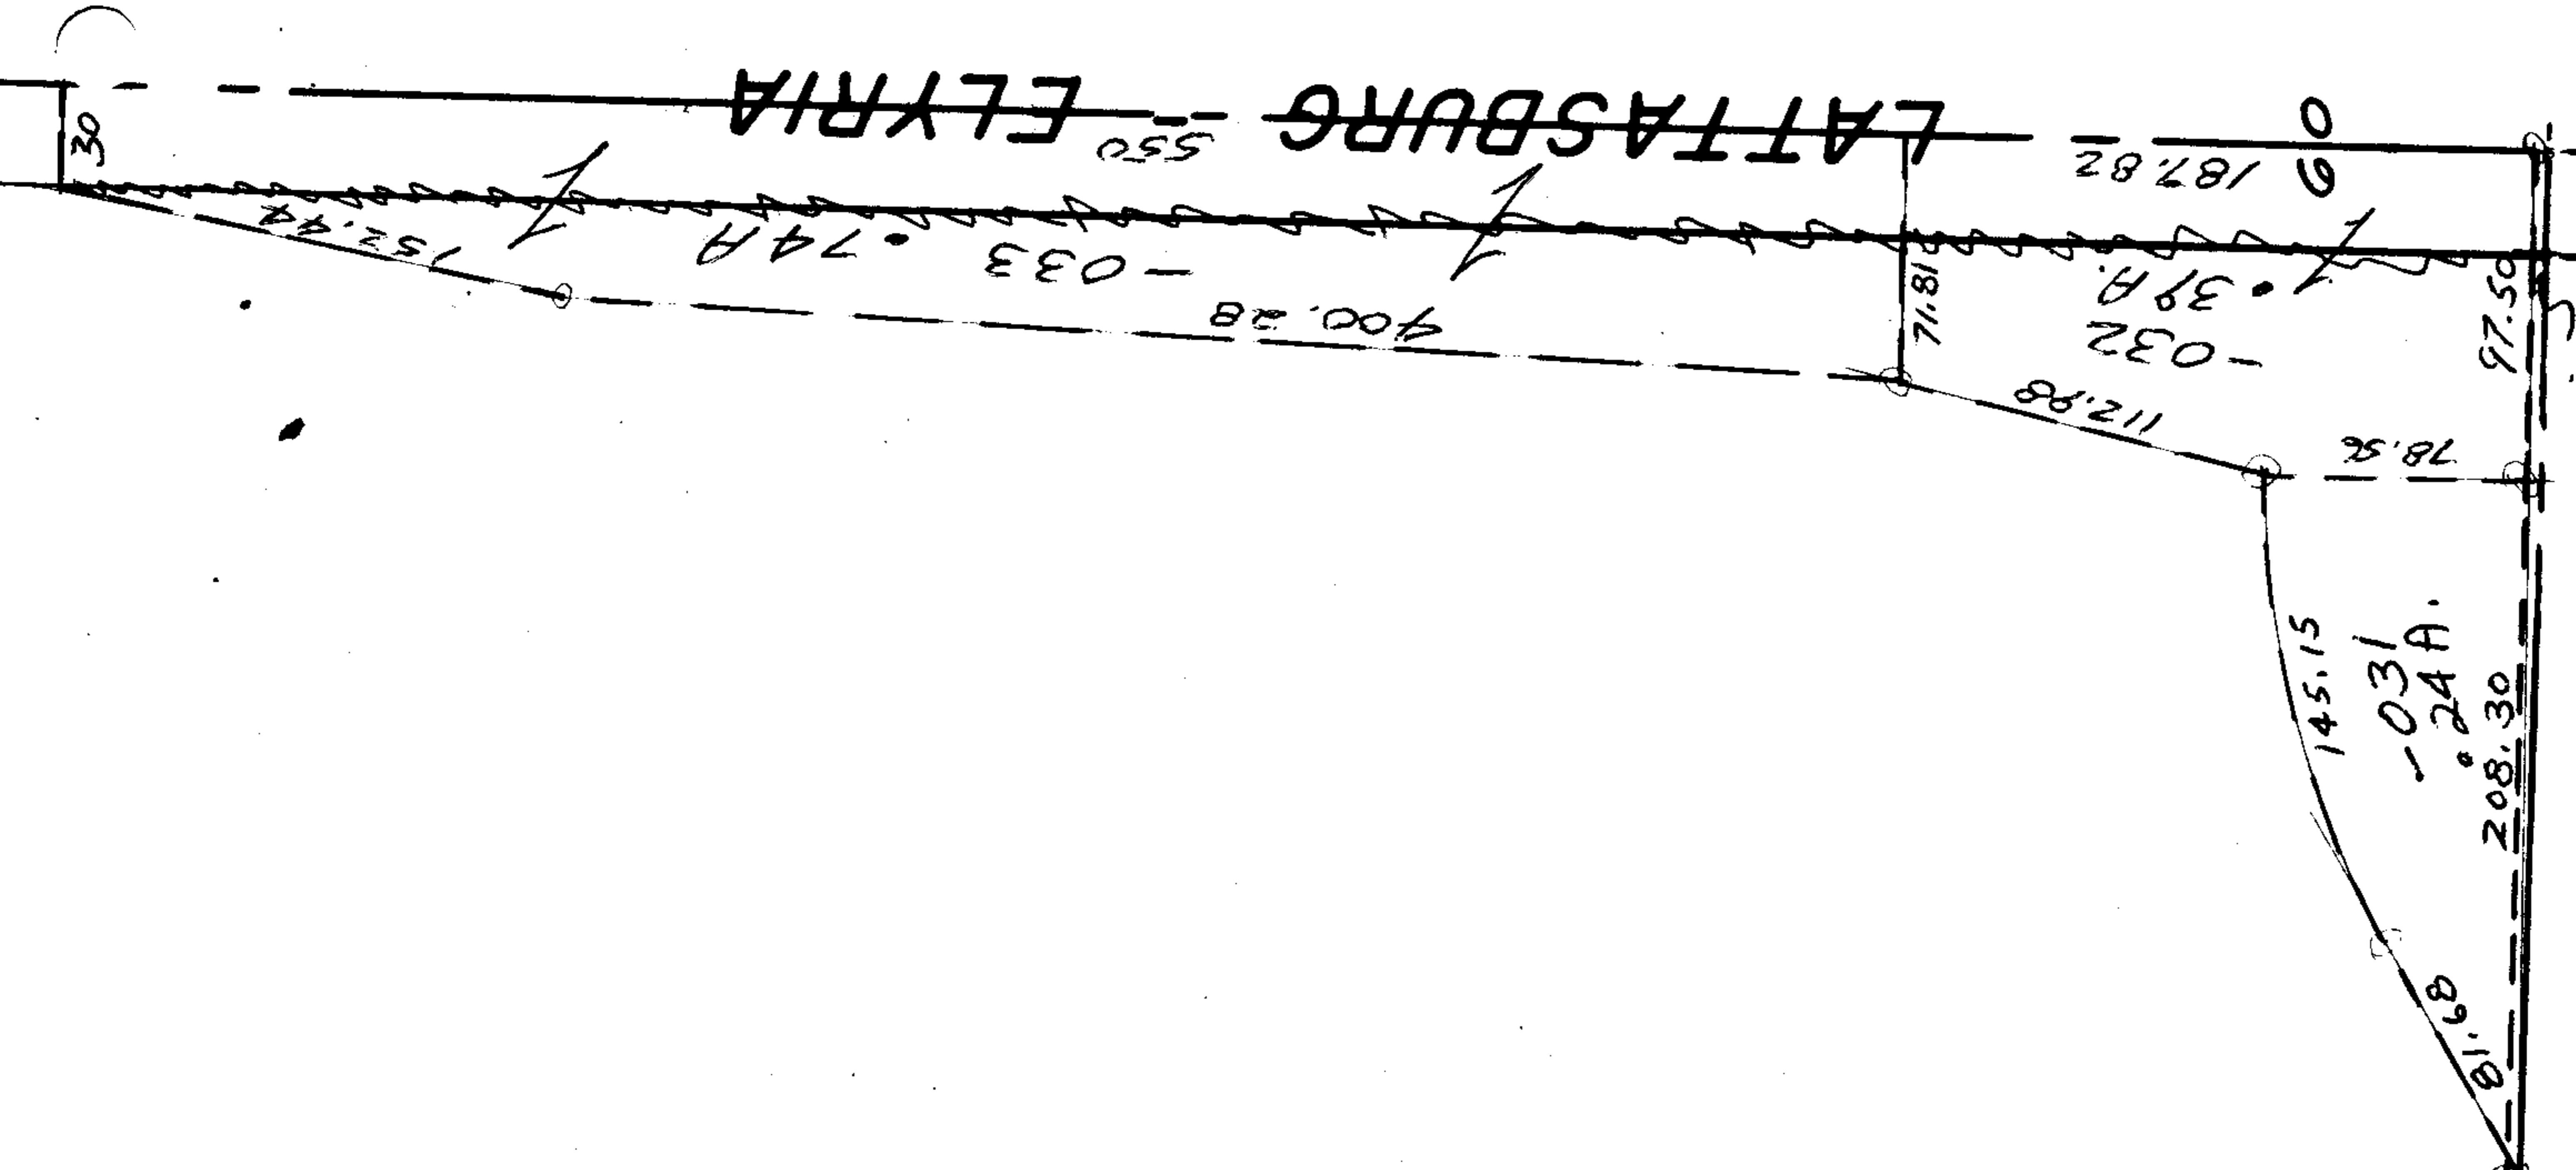

N. Kochis

Done 7/3/68

187.82
152.44
128.00
N. Kochis

LATTASBURG ELYRIA

-033-74A

400.28

112.98

145.15

-031-24A.

208.30

1162

187.82

-032
1.39A.

97.50

81.68

78.56

71.81

30