


~~058~~ - 062  
18.00 A 17.50 A


# 18225

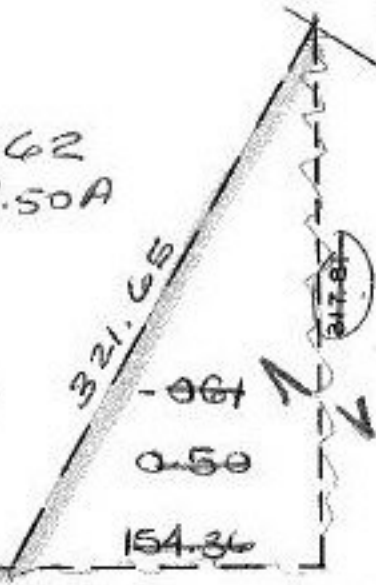

SEE SURVEY MAP BY  
JOHN HAMILTON  
CL. 1: 76923

PRIOR DEEDS 660/390, 405/457

- 067  
33.53 A.

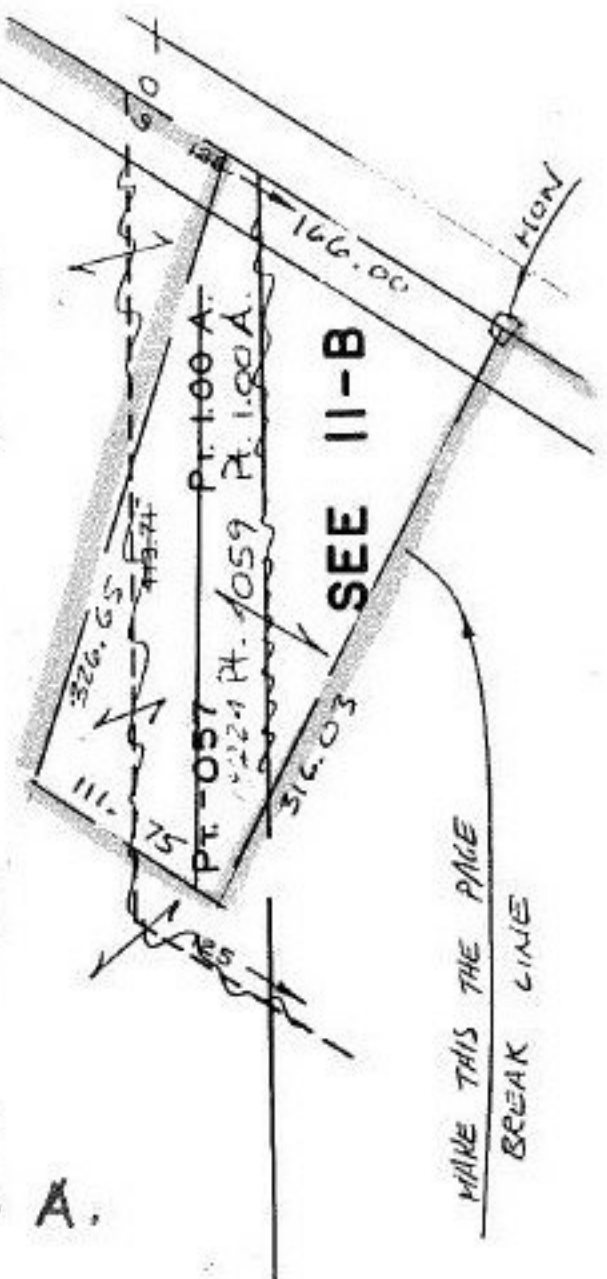

137.36  
100  
235.50

418.58

PT. - 060  
PT. 33.03 A.

PT. 058  
PT. 33.03 A.

# COMBINATION

3/17/89  
#18251A

#18224

APPROVED
LORAIN CO.
MAP DEPT.
DATE 12-13-88
PAGE 11-00-074 A
BY CAROL FRANKS
VOID AFTER # 18251A

APPROVED
LORAIN CO.
MAP DEPT.
DATE 11-21-88
PAGE 11-00-074 A
BY L. McManis
VOID AFTER 18224