


Map - 011
No. 0.64A

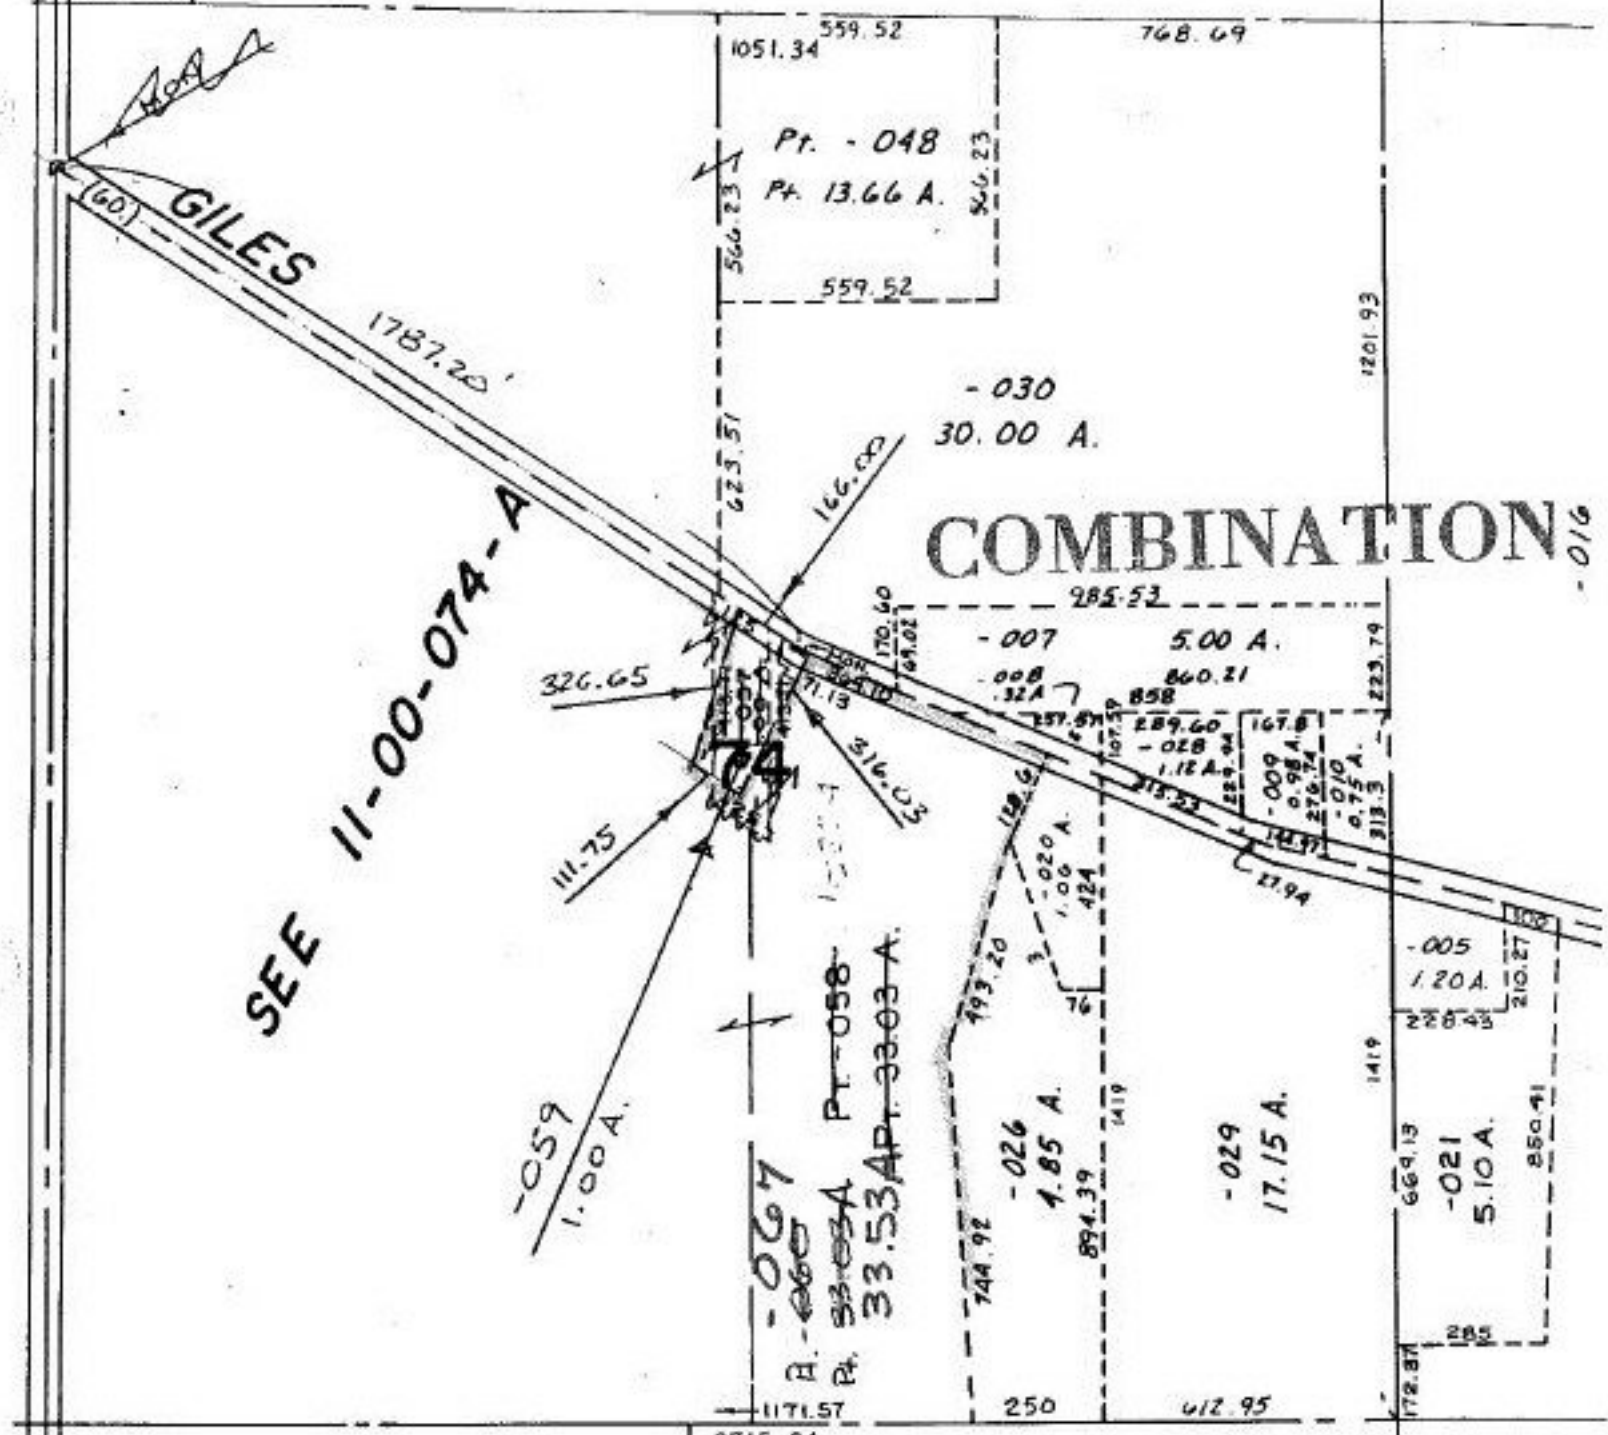

SEE 11-00-074-A

COMBINATION

SEE SURVEY MAP CL. *SH* 3/17/89
 JOHN HAMILTON
 PRIOR PLOEDS #18251A
 E60/390, 1405/457 APPROVED

#18224

APPROVED
 LORAIN CO.
 MAP DEPT.
 DATE 11-21-88
 PAGE 11-B
 BY T. J. McMan
 VOID AFTER 118224

LORAIN CO.
 MAP DEPT.
 DATE 12-13-88
 PAGE 11-B
 BY C. FRANCIS
 VOID AFTER 118251-A

Pt. -001
Pt. 80.00 A.

75

20.00 A.