


~~017~~  
20.16 A

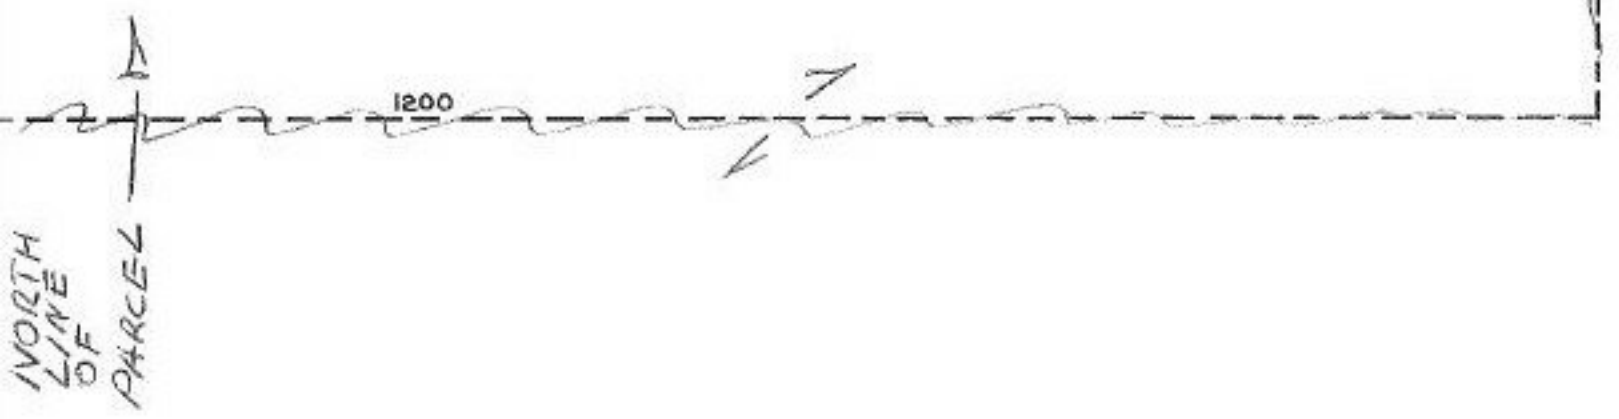

WEST LINE - To  
3095.29

~~186.33~~  
~~186.41~~  
220

# COMBINATION

1822A

101

No. CORR. PER  
Survey

ON 1/24/89  
#18253 A

APPROVED  
LORAIN CO.  
MAP DEPT.

DATE 12-15-88

PAGE 4-00-020 - E

BY Carol France

VOID AFTER #18253 A

~~061~~

Pt. - 060

~~18569 A~~

Pt. 164.86 A.

18633A

SOUTH LINE 2540 14