


03-00-107-101-
 PRIOR INST. 1090/840
 SURVEYED BY: JOHN HAMILTON
 C=1:200000. REG. SURVEYOR

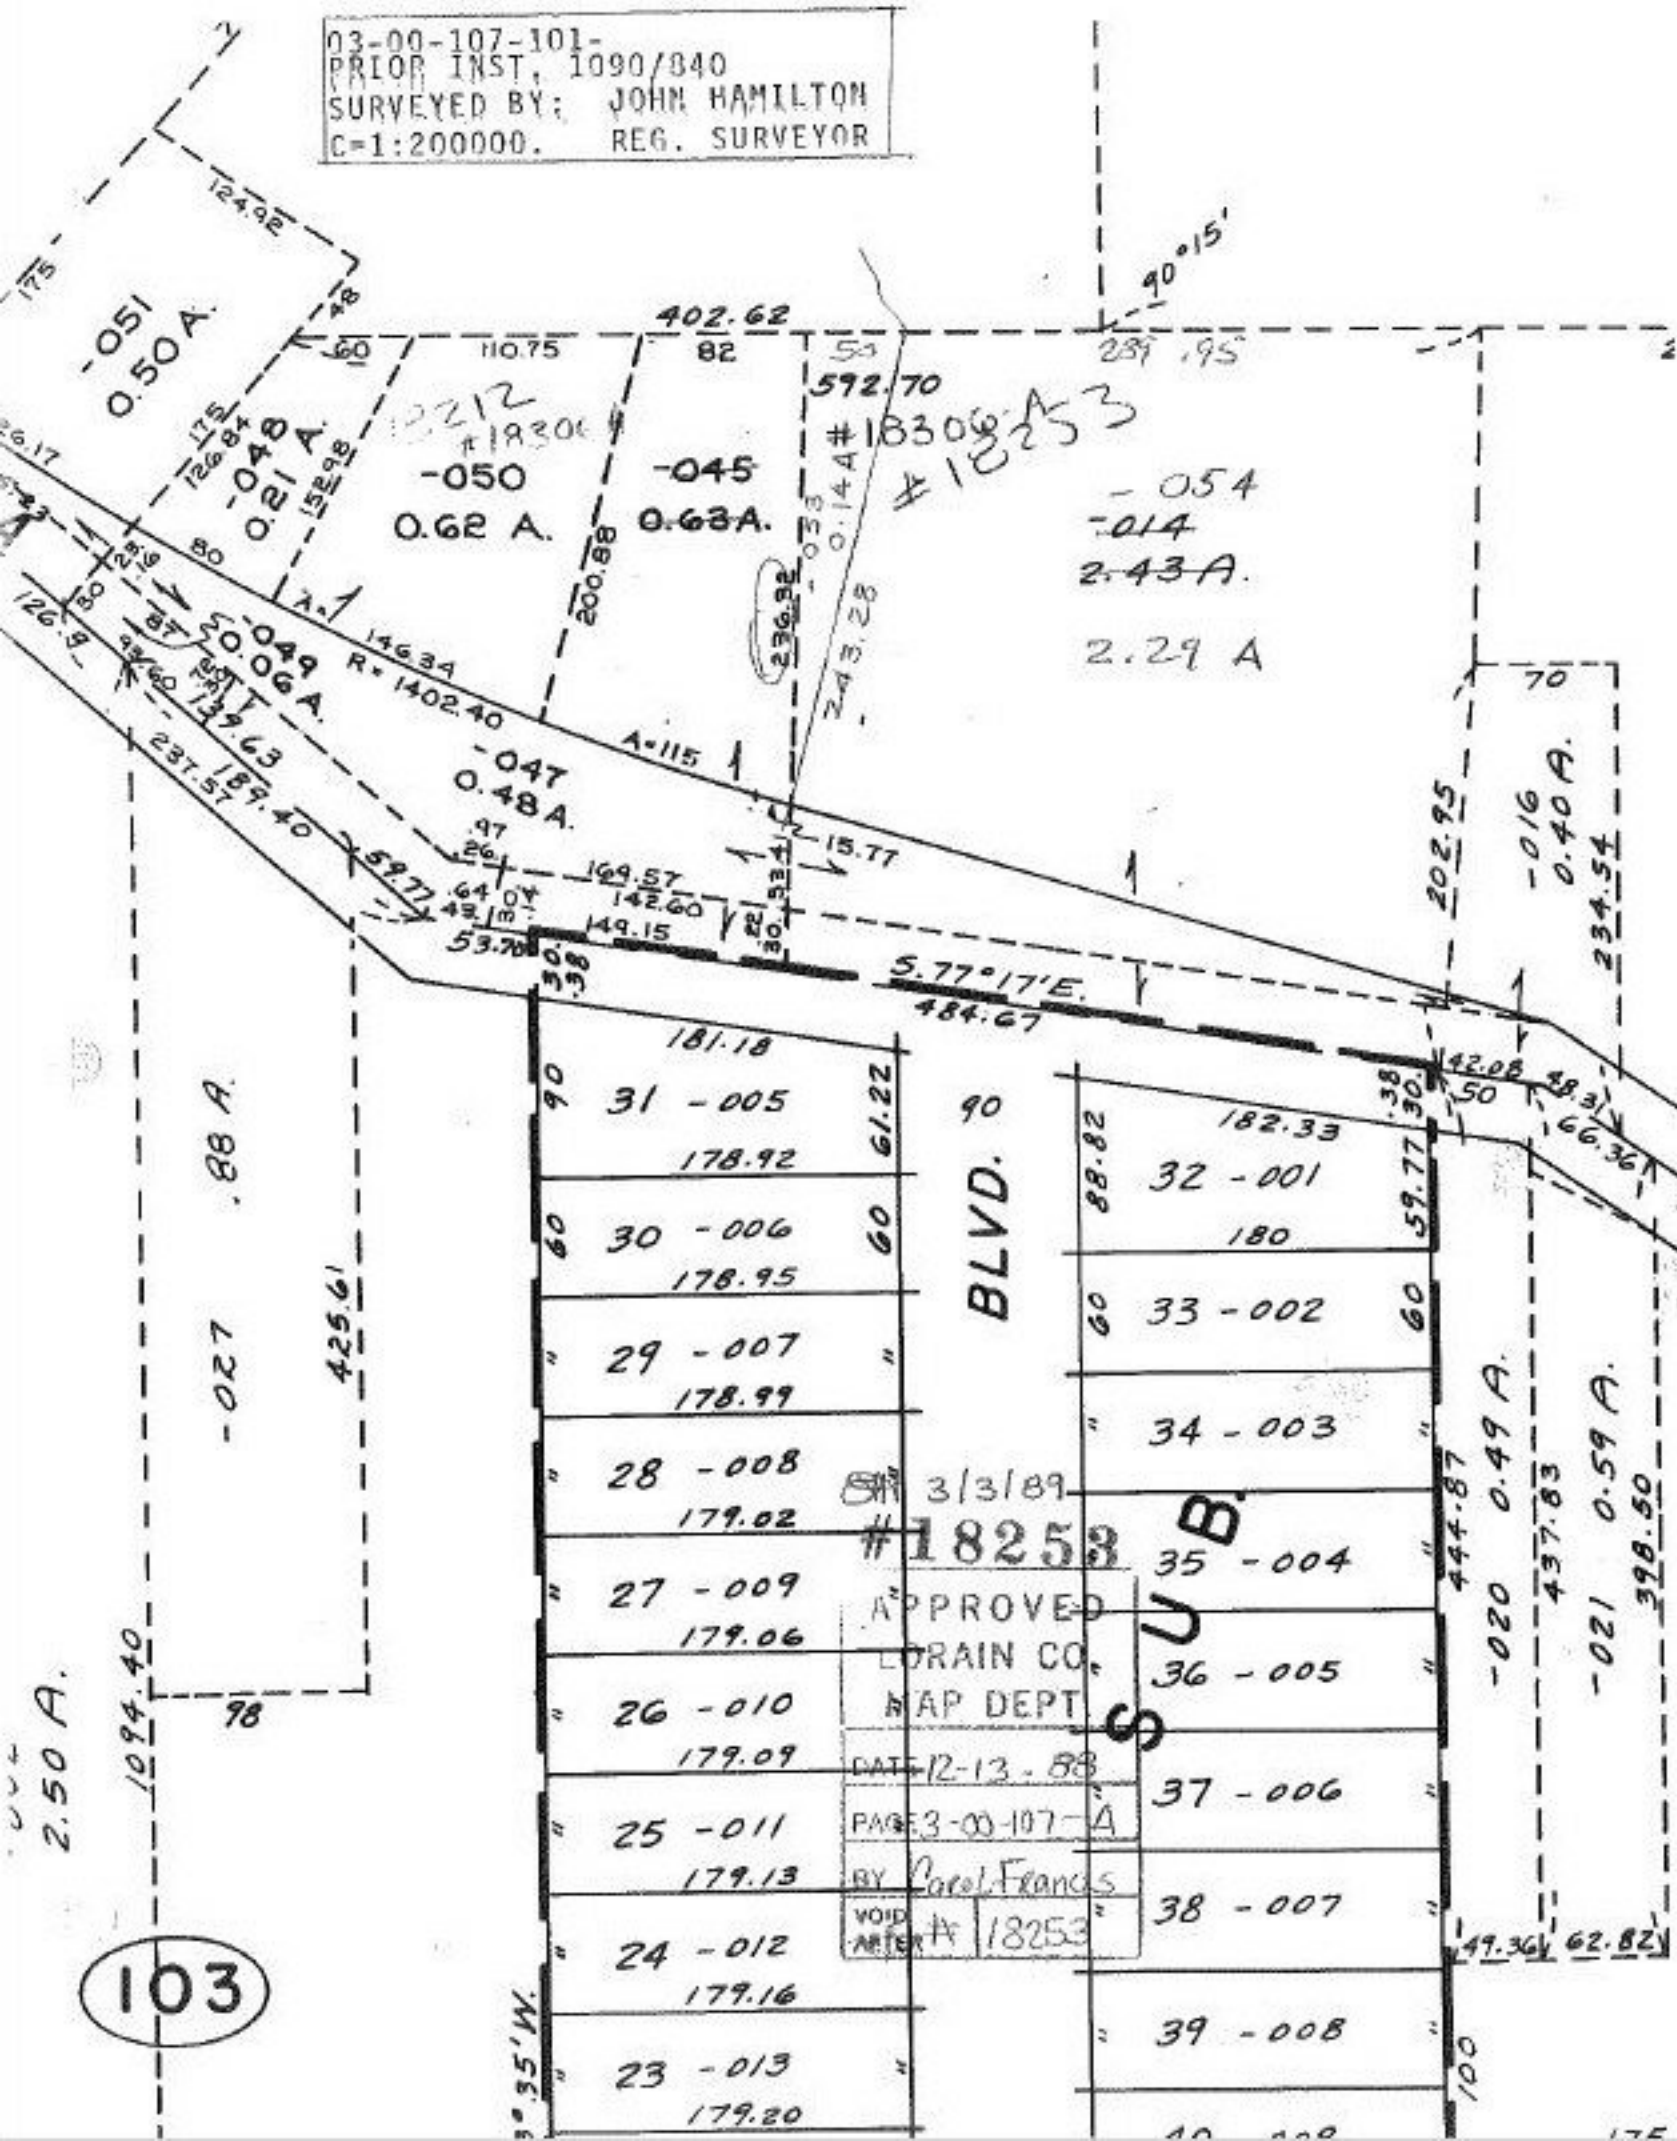

3/3/89
 #18258
 APPROVED
 LORAIN CO.
 MAP DEPT.
 DATE 12-13-88
 PAGE 3-00-107-A
 BY Carol Francis
 VOID AFTER #18253

103