


20-16-A

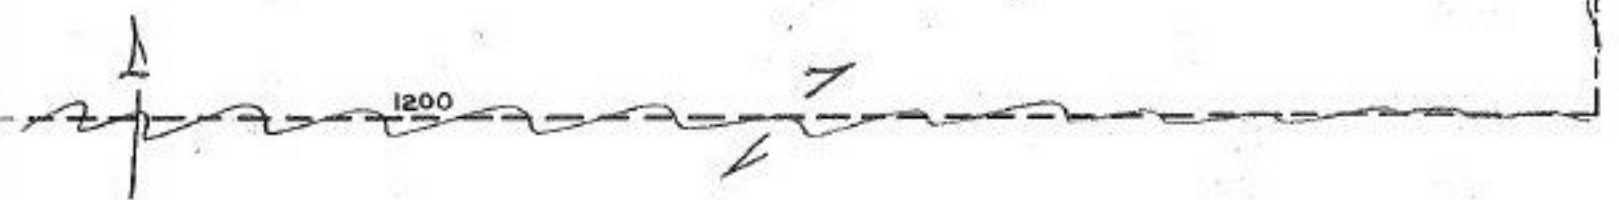

WEST LINE - To
3095.29
NORTH LINE OF
PARCEL

SM 1/24/89
#18261A

APPROVED LORAIN CO. MAP DEPT.	
DATE 12-27-88	
PAGE 4-00-020-E	
BY <i>Cb</i>	
VOID AFTER	#18261-A

COMBINATION

(101)

Ac. CORR: To show
acreages to SIDELINE
OF RW on Deed.

Ac. CORR. per
Survey

#18253A

APPROVED LORAIN CO. MAP DEPT.	
DATE 12-15-88	
PAGE A-00-020-E	
BY Carol Francis	
VOID AFTER	#18253-A

- 061
Pt. - 060 ~~185.69 A~~
Pt. 164.86 A. ~~186.33 A~~ W

186.11 A

254 Co. 14