


SEE 12-E

CAPEL

CAPEL RD

60.00 140 140 140 140 140 140 139.82 280

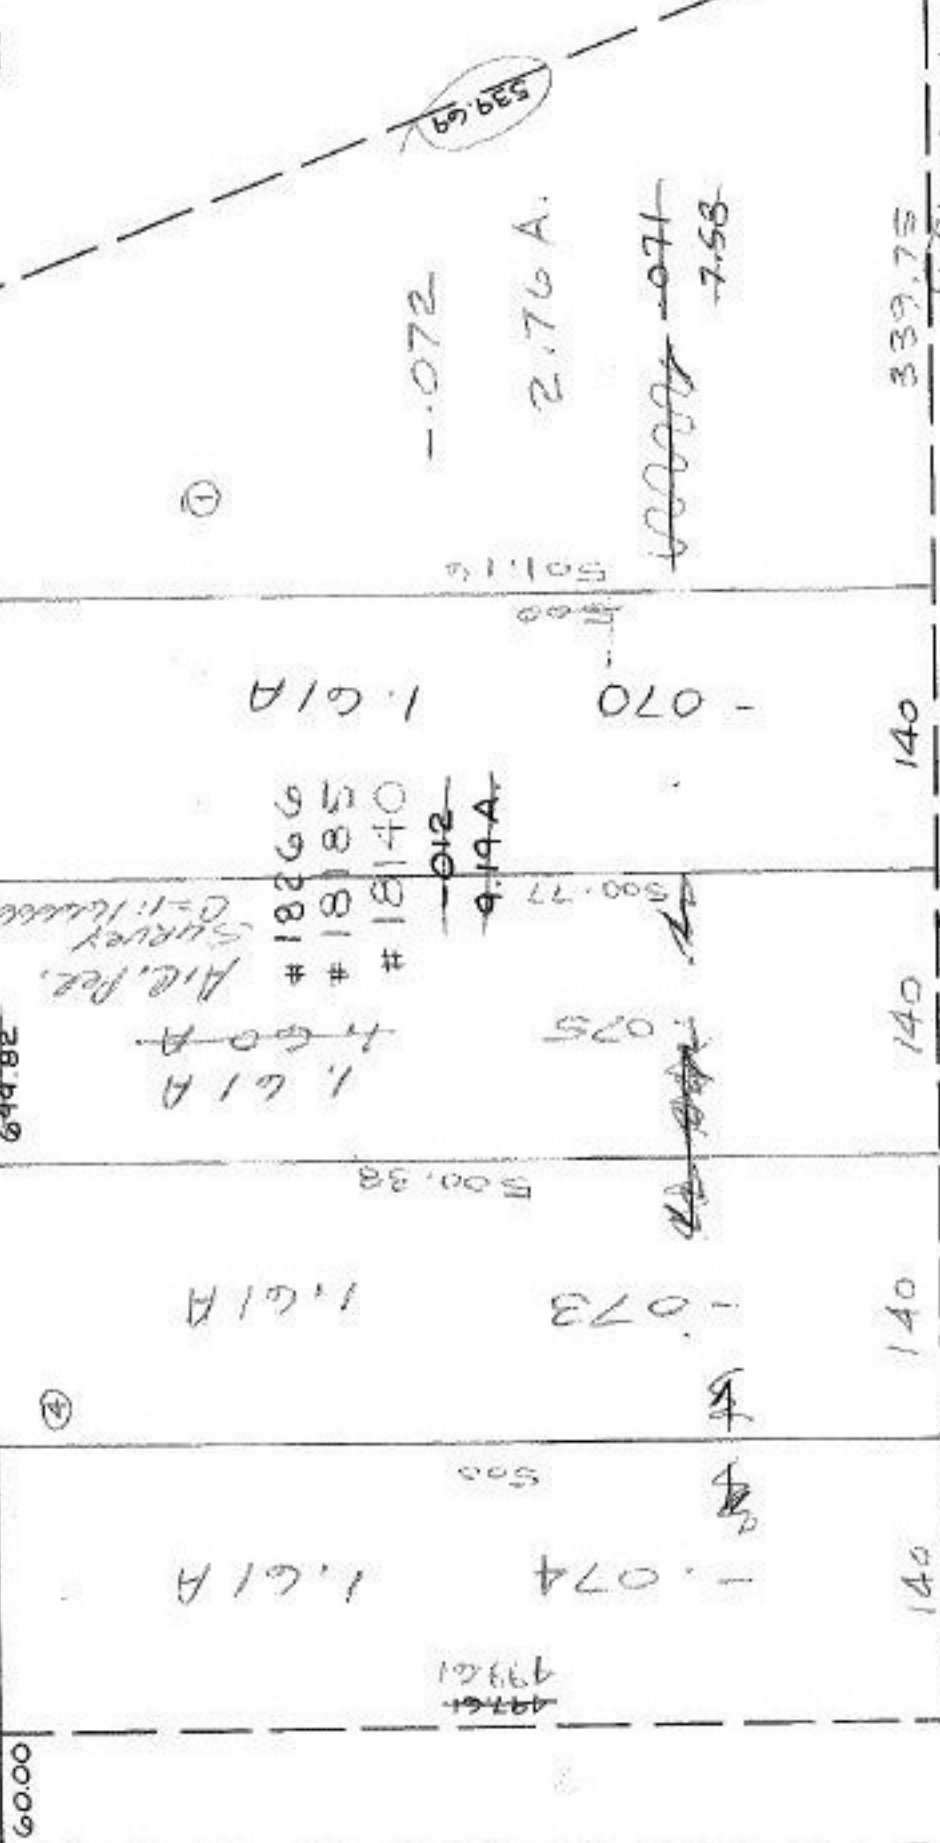

12-00-088-000-
 PRIOR INST. 1412/619
 SURVEYED BY: JOHN POZYMAK
 1. C-1: 30303REG. SURV.
 2. : 76923.
 3. : 166666.
 4. : 166666.

APPROVED	
LORAIN CO.	
MAP DEPT.	
DATE	12-23-88
PAGE	12-23-88 B
BY	<i>John Pozymak</i>
VOID	
METER #	152666

-010
15.00 A.