


The Distance of 15 To 132 FT.

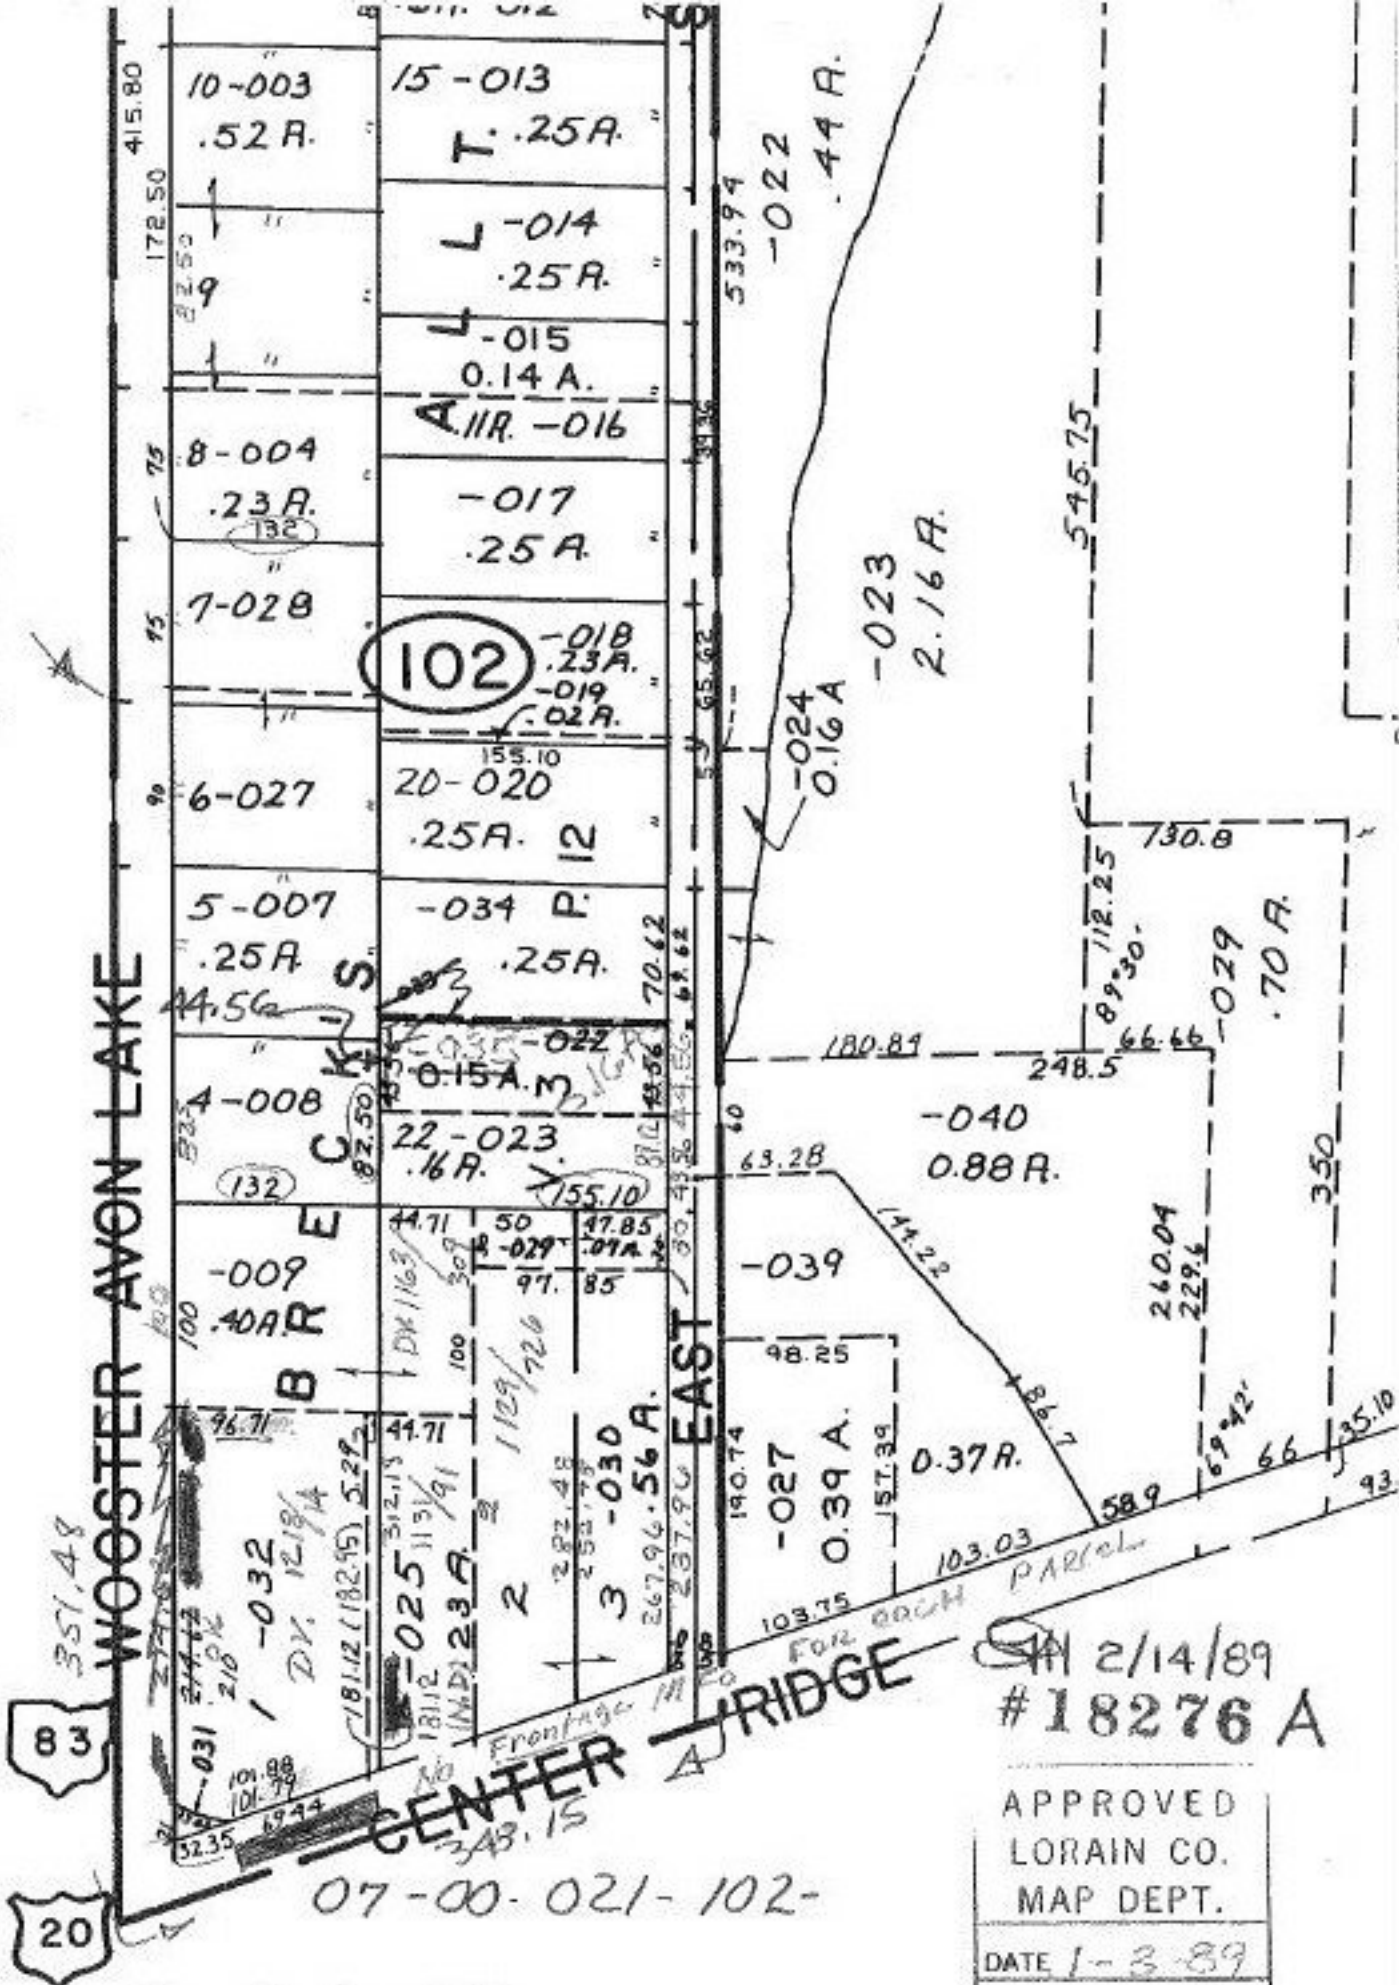

83
20

WOOSTER AVON LAKE

CENTER RIDGE

07-00-021-102-

2/14/89
#18276 A

APPROVED
LORAIN CO.
MAP DEPT.
DATE 1-3-89
PAGE 7 of 21 A
BY [Signature]
VOID AFTER 1/31/89

COMBINATION