


(1-13-89)

TRANSFER SHEET SUBMITTED FOR SPLIT.

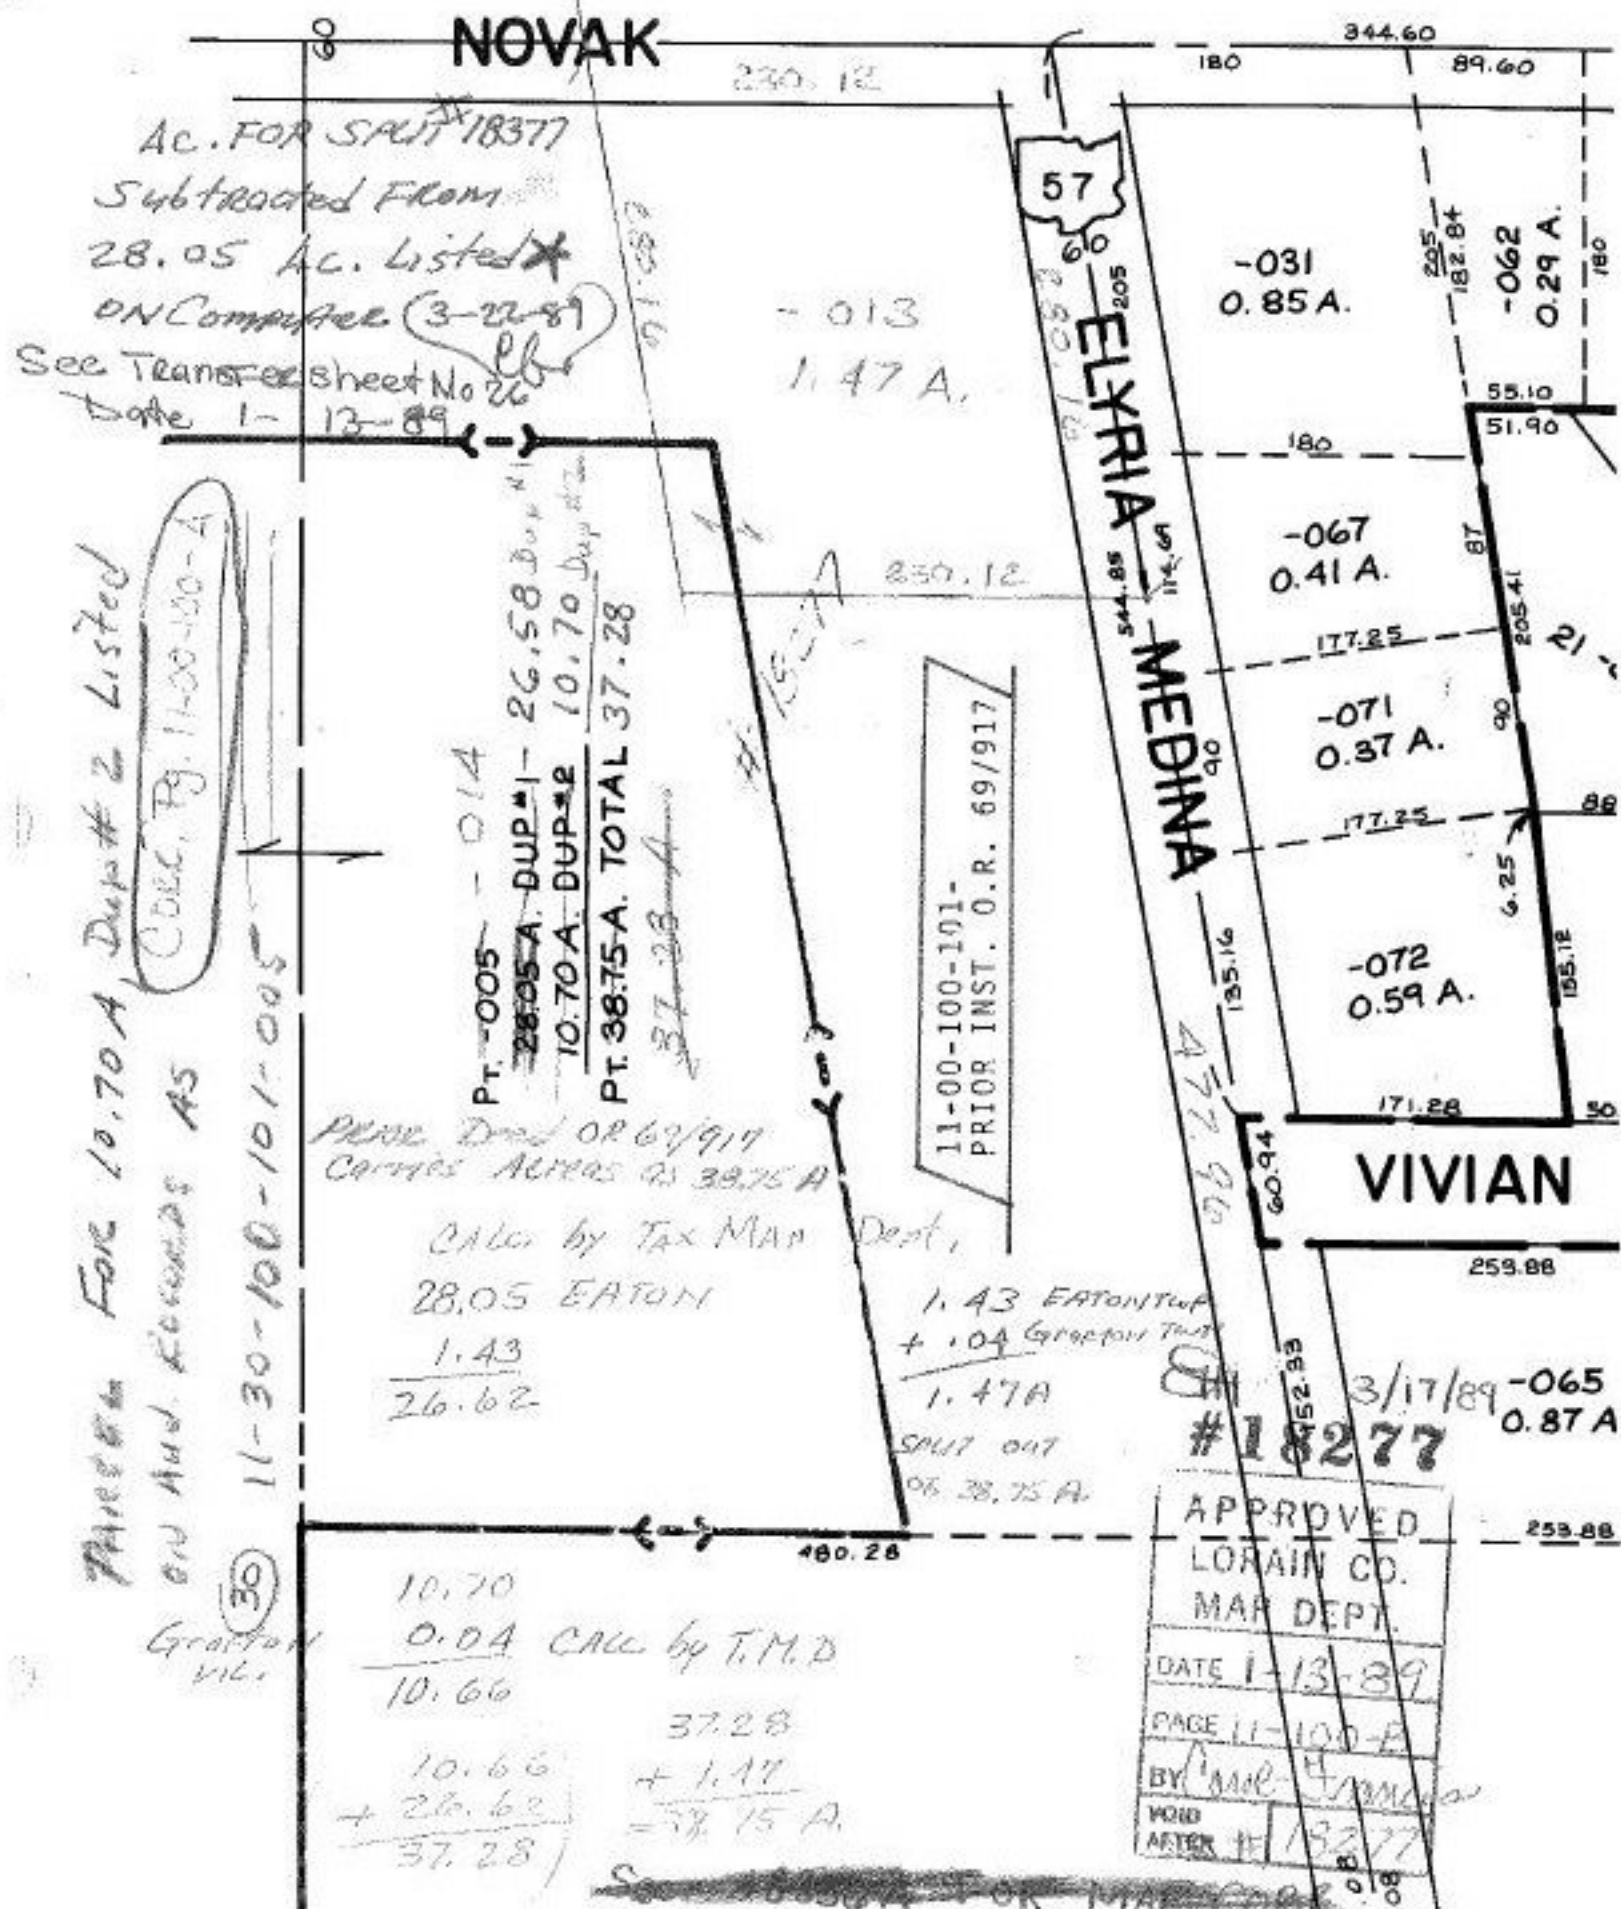

NOVAK

344.60

230.12

180

89.60

Ac. FOR SPLIT 18377

Subtracted From

28.05 Ac. Listed

ON Computer (3-22-81)

See Transfer sheet No 26

Date 1-13-89

- 013

1.47 A.

-031
0.85 A.

-062
0.29 A.

-067
0.41 A.

-071
0.37 A.

-072
0.59 A.

VIVIAN

259.88

-065
0.87 A

259.88

11-00-100-101-
PRIOR INST. O.R. 69/917

PENE Dred OR 6/9/917
Carries Across 9.3875 A

CALC by Tax MAP Dept.

28.05 EATON

1.43

26.62

1.43 EATON Twp
+ 0.04 Gravel Pit

1.47 A

SPLIT out

0% 38.75 A

3/17/89
#18277

APPROVED
LORAIN CO.
MAP DEPT.

DATE 1-13-89

PAGE 11-100-E

BY [Signature]

VOID AFTER #18277

10.70

0.04 CALC by T.M.D

10.66

37.28

10.66

+ 26.62

37.28

+ 1.47

= 38.75 A.

Parcel # 10.70 A, Dup # 2 Listed
on Aud. Records AS
Colec. Pg. 11-00-100-101-005

11-30-100-101-005

30

Gravel Pit

NOVAK