

DEED CHECK

ACREAGES CORRECTION IS NEEDED ON DEED. ALSO THERE IS A TYPING ERROR ON DEED, THE ACREAGE ON DEED READS 10.47 A. INFORMATION TAKEN FROM RECORD IT SHOULD READ 10.49 A. P. P. NO. 18-00-021-101-066 WAS NOT INCLUDED IN THE CALCULATION OF THE ACREAGES ON THE DEED.

Deed should Read 10.68 A.

18-00-021-101-066 50x165 = 0.19A

10.49A + 0.19A = 10.68A


SEE 18-C

PG. 55

VOL. 42

MAPLE STREET DEDICATION PLAT

APLE

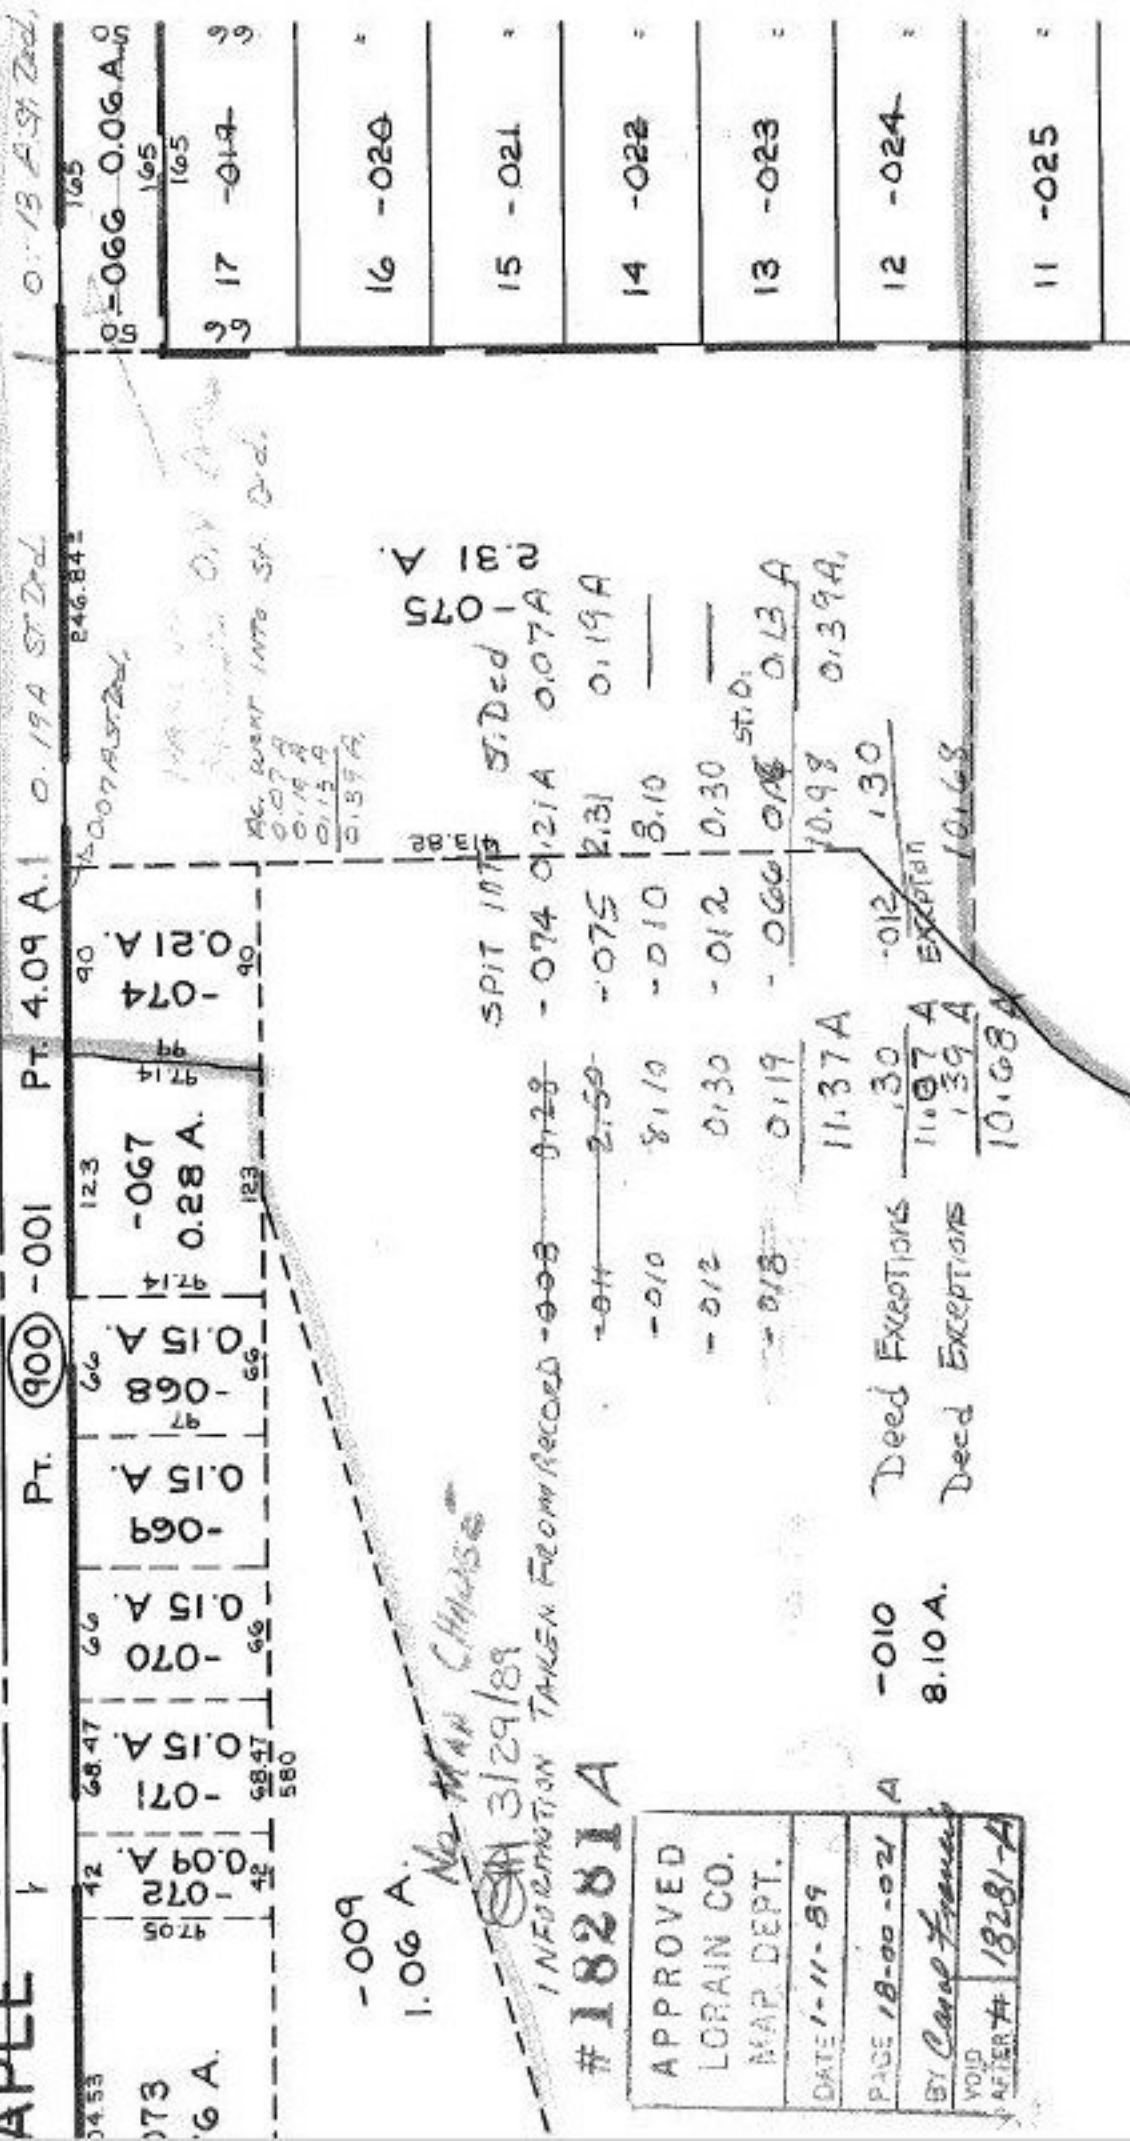

-009  
1.06 A.

No Map Change  
3/29/89

INFORMATION TAKEN FROM RECORD

#18281A

APPROVED
LORAIN CO.
MAP. DEPT.
DATE 1-11-89
PAGE 18-00-021 A
BY Carol Franck
VOID AFTER # 18281-A

-010 Deed Exceptions 11.30

8.10 A. Deed Exceptions 13.9 A

10.68A

-012 EXCEPTION 1.30

10.68

10.98 0.39A

0.19A 0.13A

8.10

0.30

2.31 0.19A

0.75

0.07A

0.19A

0.15A

0.137A

0.07A

0.19A

0.13A

0.137A

0.07A

0.19A

0.13A

0.137A

0.07A

0.19A