
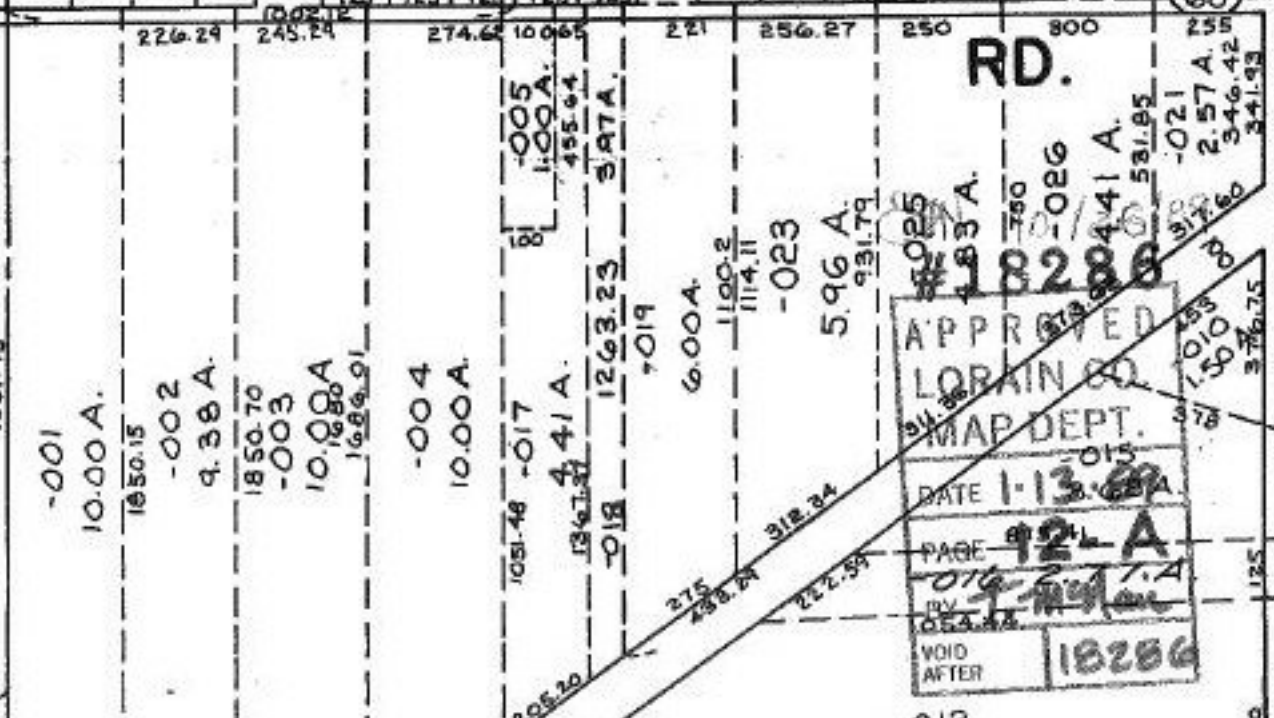


082-B

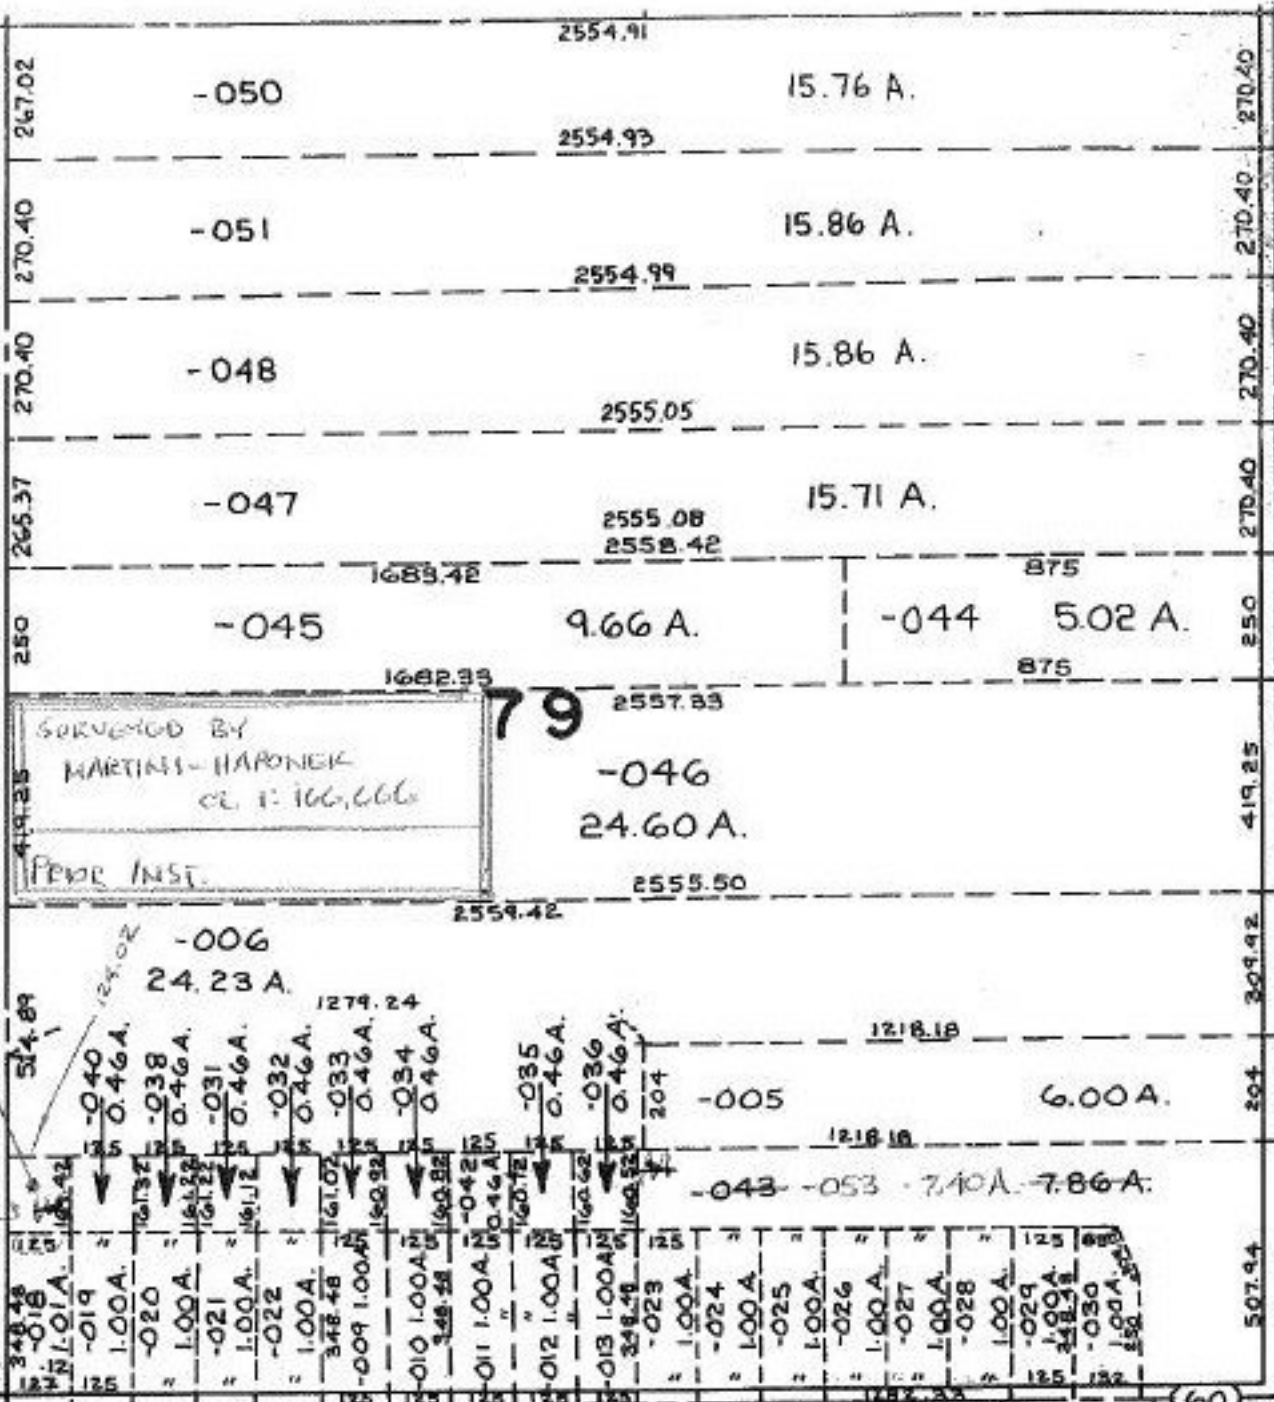

SURVEYED BY
 MARTINI-HARONICK
 CO. P. 106, 666
 P.P.M. INST.

APPROVED
 LORAIN CO.
 MAP DEPT.
 DATE 1-13-68
 PAGE 92-A
 BY 016 053.44
 VOID AFTER 18286