


SN 3/3/89
#18287A

APPROVED
LORAIN CO.
MAP DEPT.
DATE 1-17-89
PAGE 3-00-043
BY Carol-Francis
VOID AFTER # 18287A

COMBINATION

33-00-043-105-029
-575

SEE INSERT

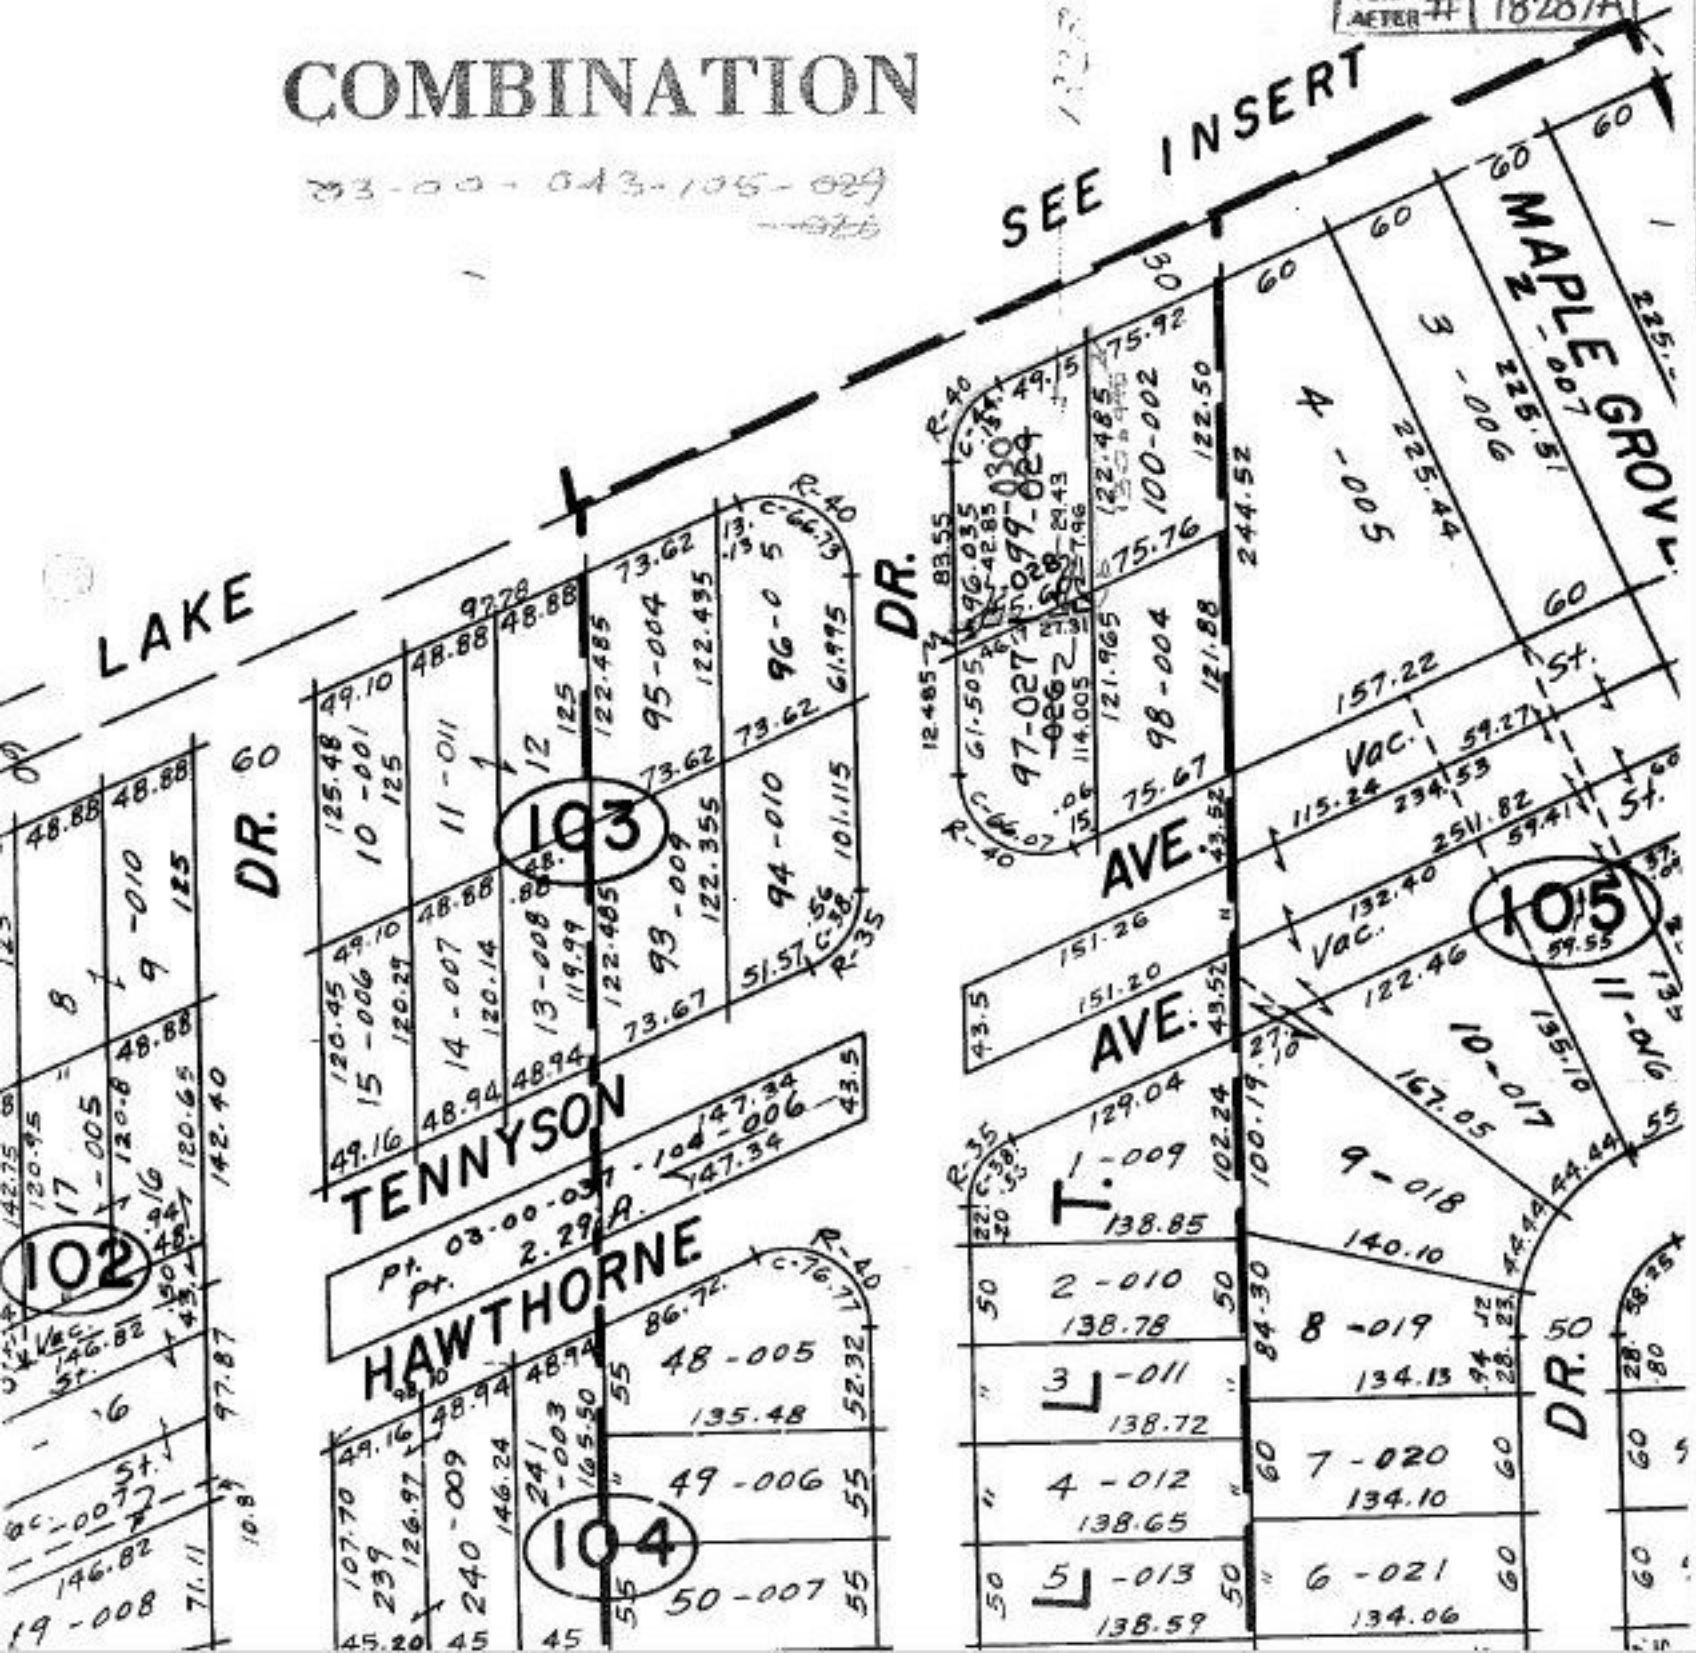

LAKE

DR. 60

TENNYSON

HAWTHORNE

DR.

AVE.

AVE.

MAPLE GROVE

DR.

102

103

104

105

Pt. 03-00-007 - 104-47.34
Pt. 2.29-A 747.34

97-027-099-824
96-005-005
95-004-005
94-010-015
93-009-005
92-008-005
91-007-005
90-006-005
89-005-005
88-004-005
87-003-005
86-002-005
85-001-005
84-000-005
83-000-005
82-000-005
1-000-005