


SEE 3 - 01

OSTER

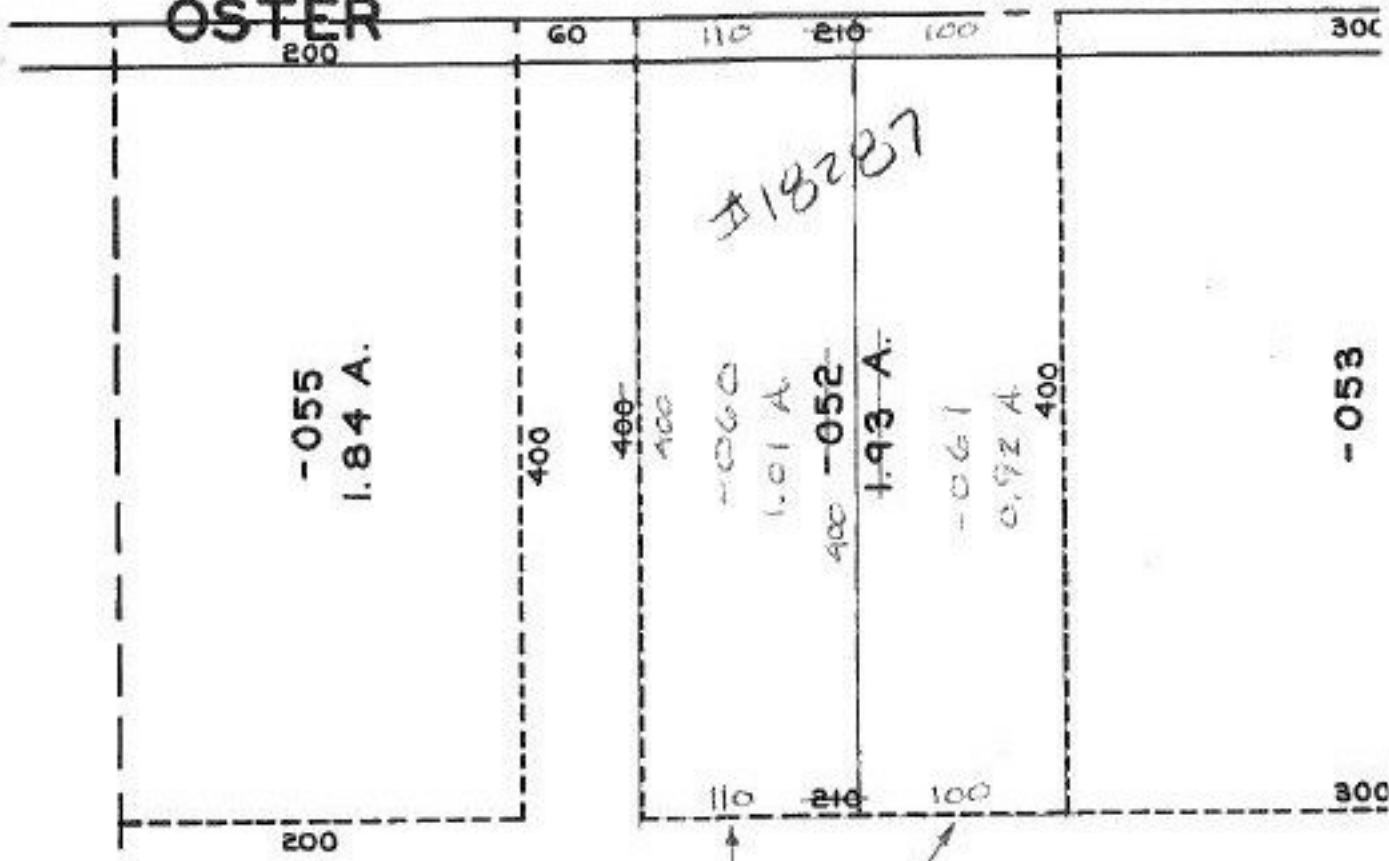

|                             |
|-----------------------------|
| SEE PARCEL MAP BY KS ASSOC. |
| PRIOR INST. OR 72/523       |
| CL. BOTH PARCELS 1:INF      |

MAY 3/3/89  
#18287

|                    |
|--------------------|
| APPROVED           |
| LORAIN CO. 056     |
| MAP DEPT. 14-28-A. |
| DATE 1-13-89       |
| PAGE 3-00-024-13   |
| BY T. McLean       |
| WORD AFTER 18287   |

6/6.01