


RIA TWINSBURG

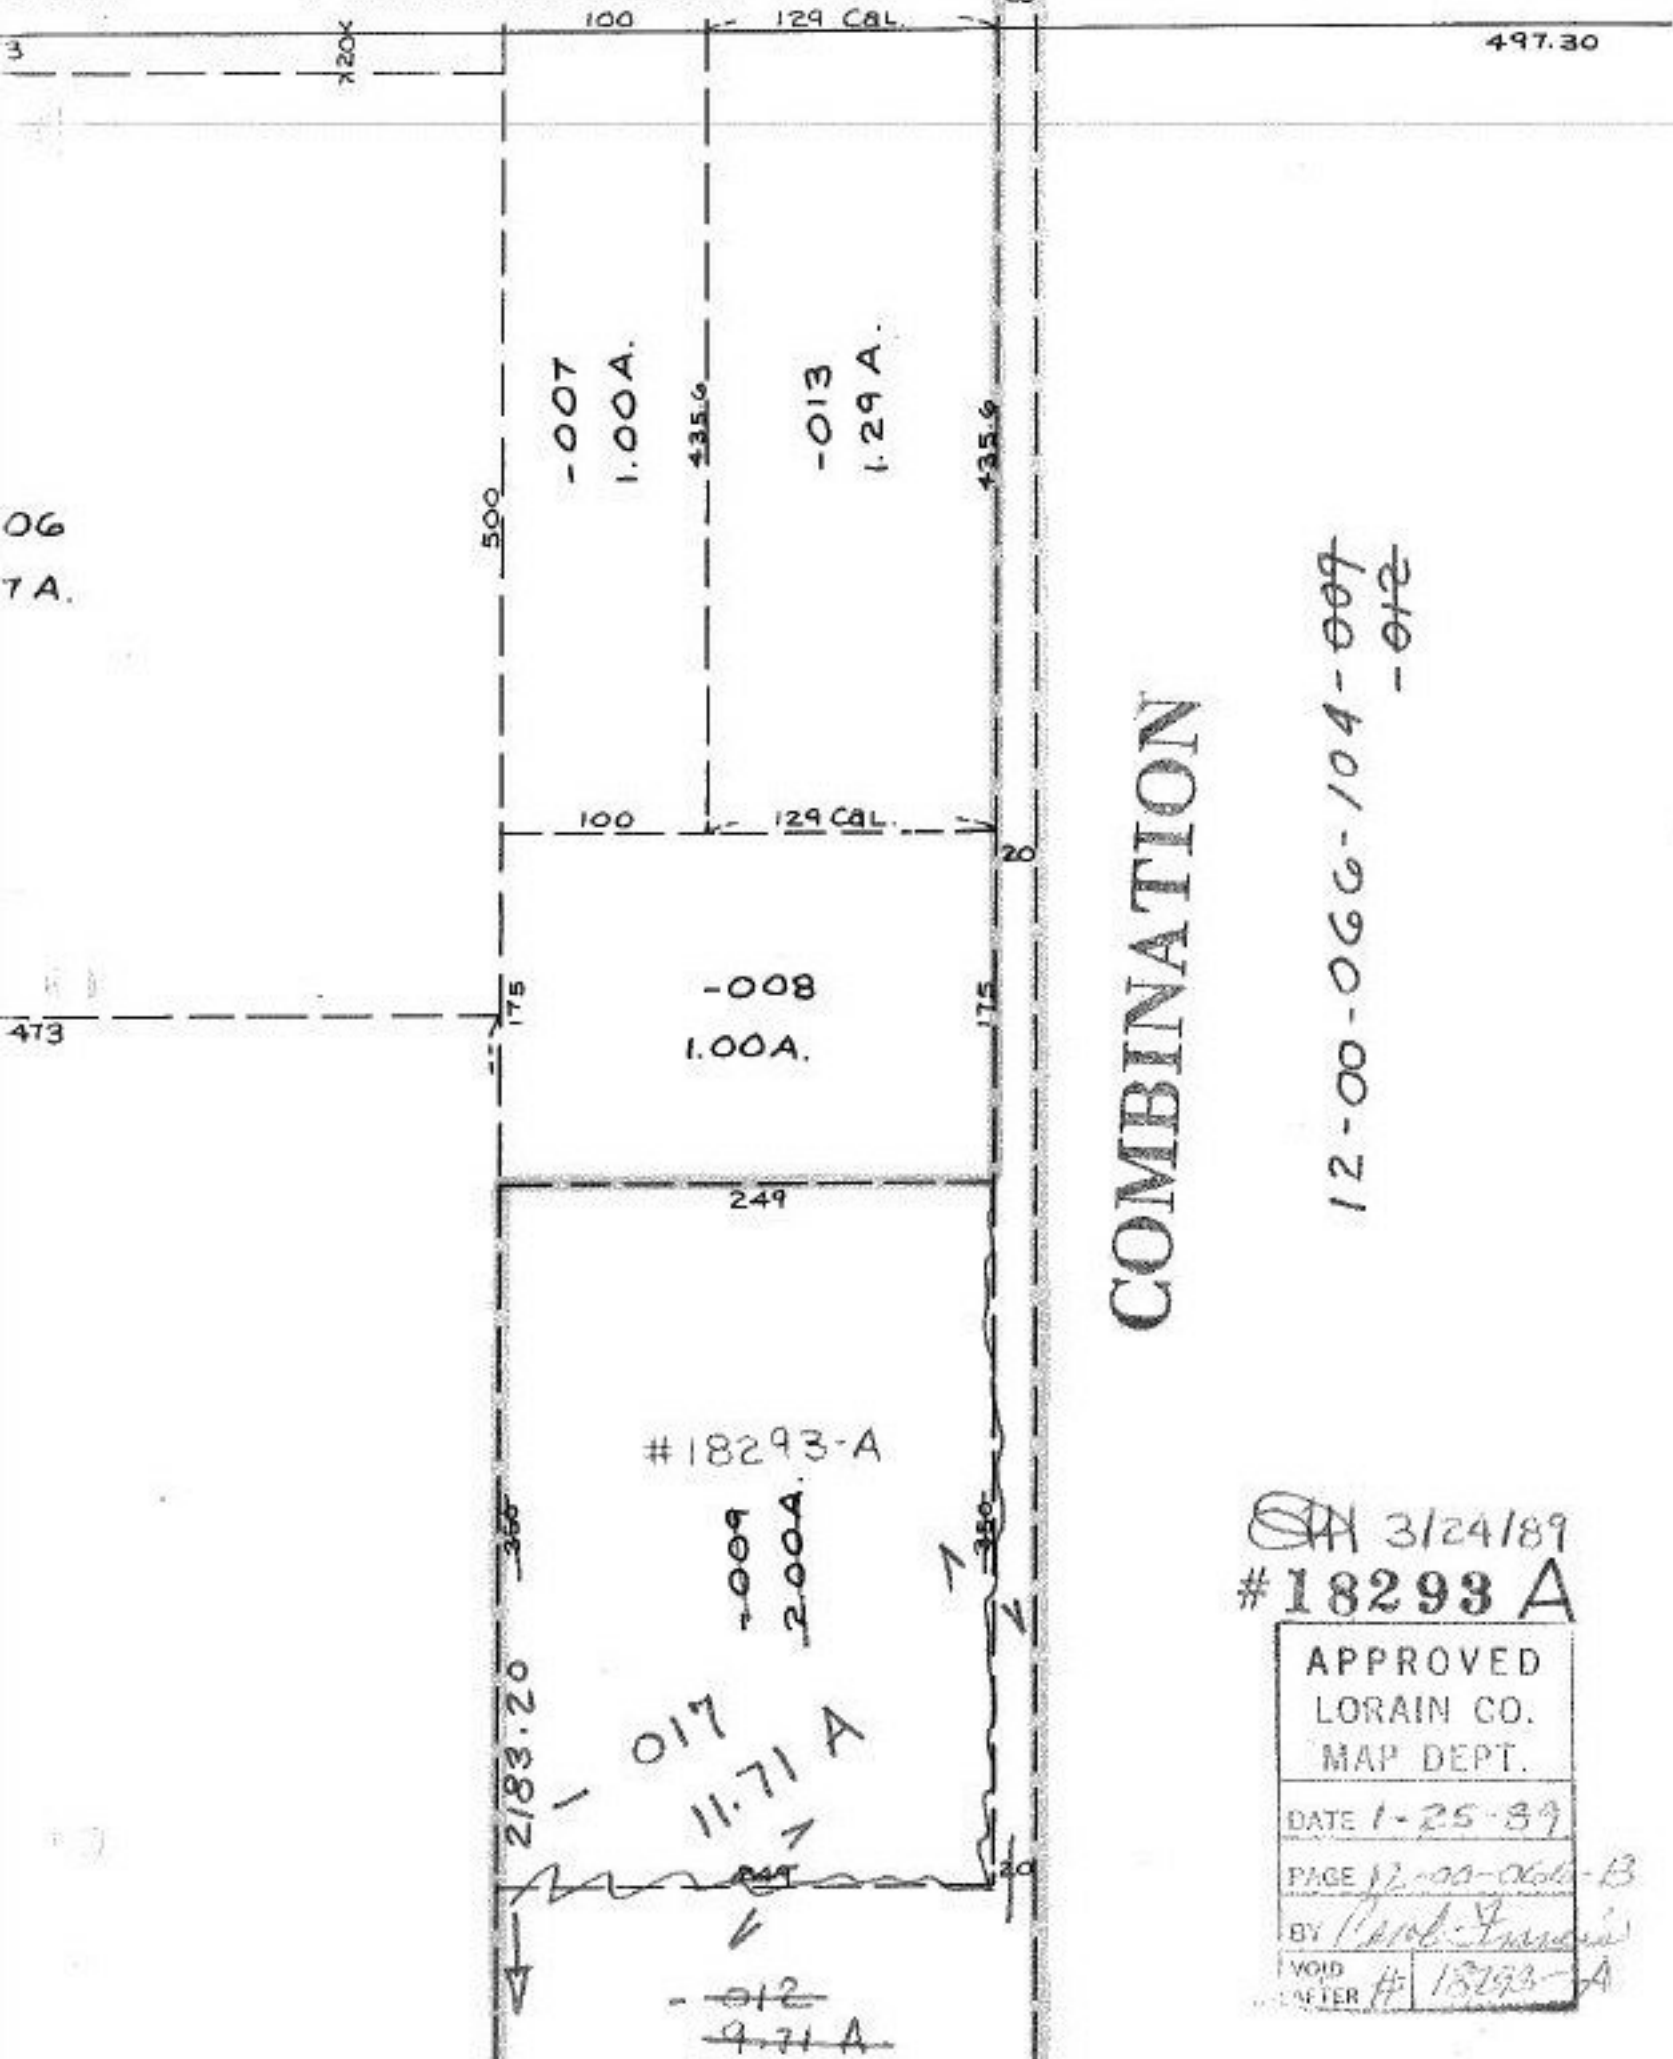

COMBINATION

12-00-066-104-007
-012

3/24/89
#18293 A

APPROVED
LORAIN CO.
MAP DEPT.
DATE 1-25-89
PAGE 12-00-066-13
BY [Signature]
VOID AFTER # 18293-A