


SEE 9-8

RNUT RIDGE 709.50 20768 300 250 660

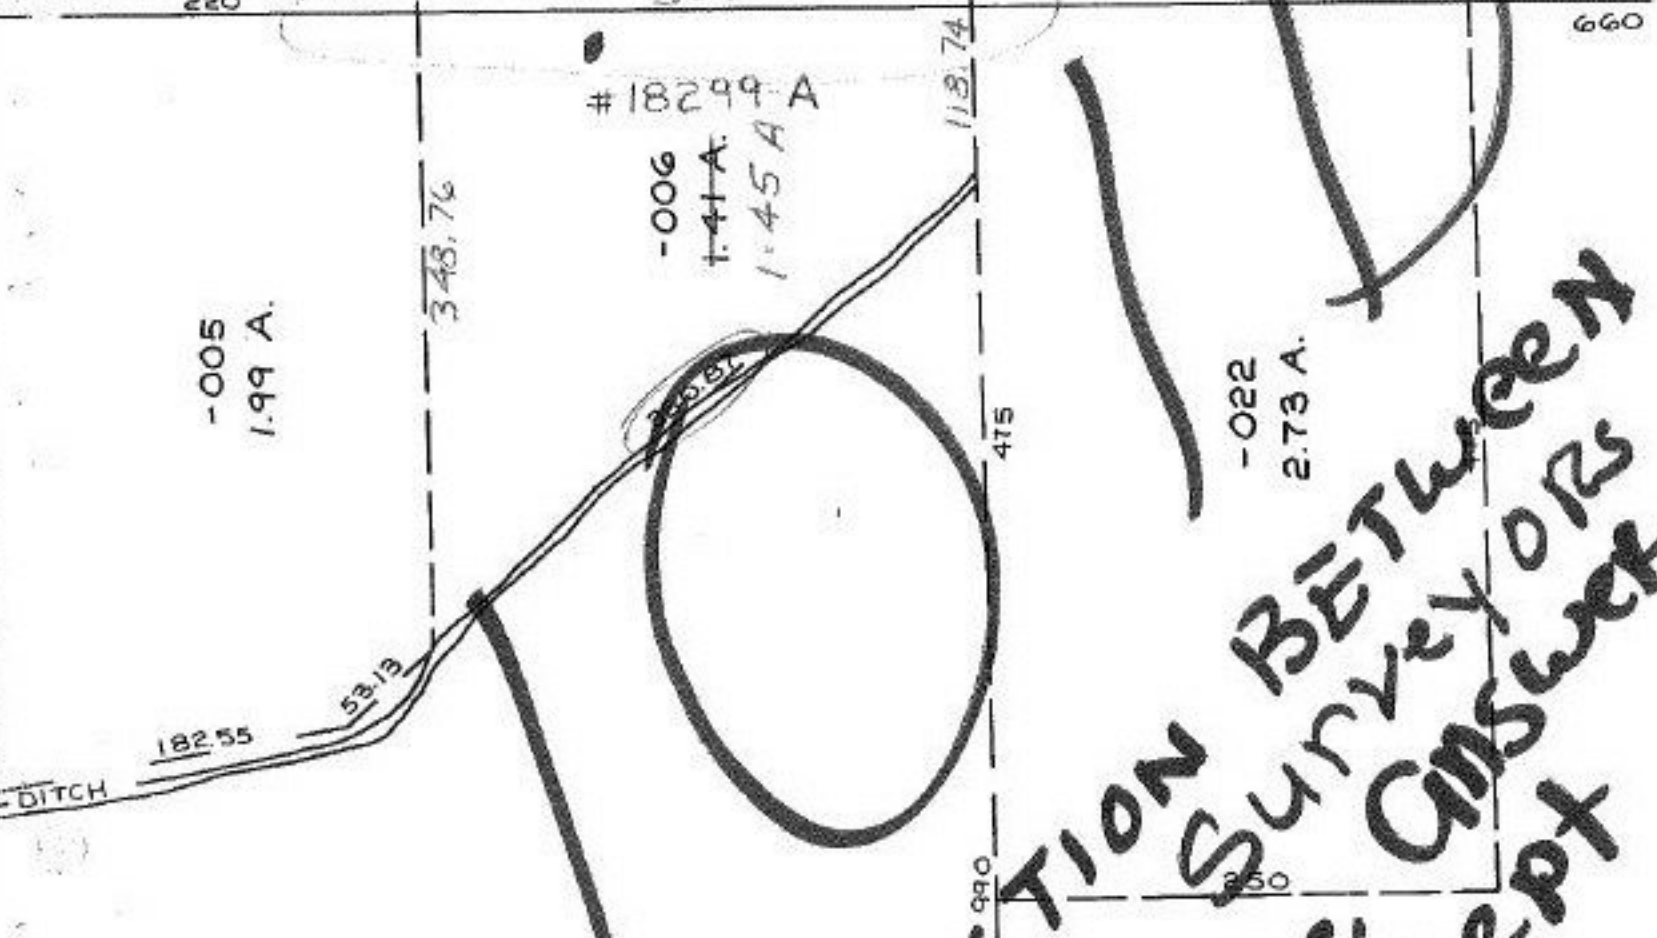

**QUESTION BETWEEN SURVEYORS
CANNOT BE ANSWERED
BY MAP DEPT**

Acreages CORRECTION

09-00-067-000-006

Acreages CORRECTION
per DV. 1417/164
Deed Surveyed by
C.E. Penfound - Reg.
C-1: 76923 Surveyor

#18299 A

| | |
|-------------------------------------|------------|
| APPROVED LORAIN CO. MAP DEPT. | |
| DATE | 2-1-39 |
| PL | 9-00-067-B |
| BY | BBS alk |
| FILE # | 18299-A |