


SEE OTHER SIDE

No MEASUREMENTS  
-001 50.00A.  
-003 49.00A.

23.70 A.  
2

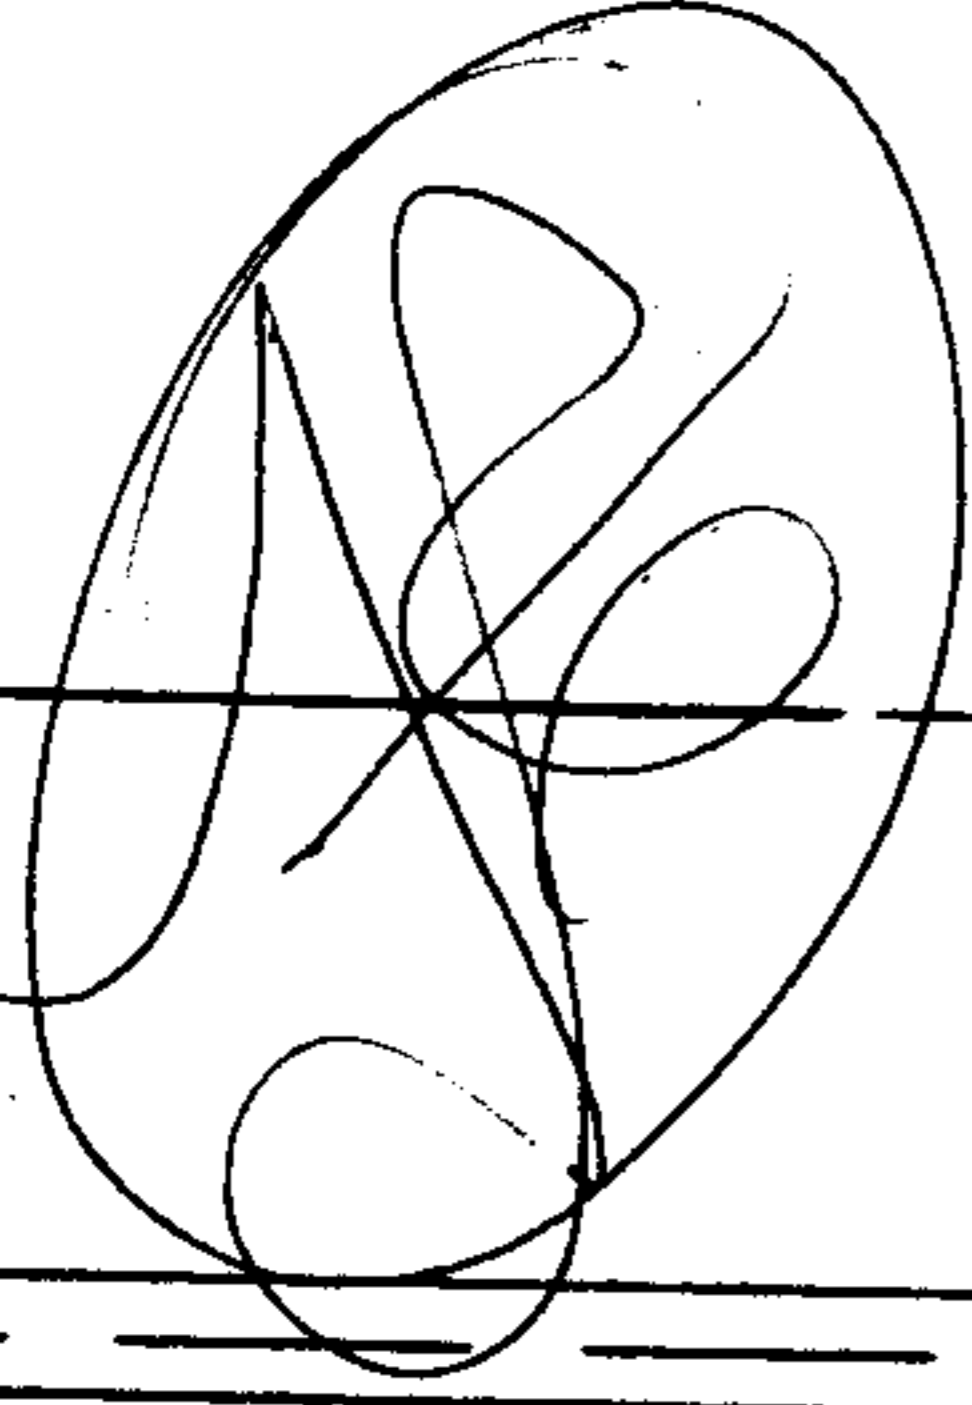

INCORRECT ACREAGE

399.86  
-004 1.00A  
399.86

-001 25.50A.

RD.

18

-002 57.82A.

-001 36.67A.

19

1830 -002 21.00A.

-003 9.00A.

-002 5.50A.

S.S.  
7-30-86

-004 76.40A.

20

273.36  
-003 1.10A.  
273.35

Done 7/20/68  
Jim Grace

(LAGRANGE RD.)

68 Rds.



APPROVED  
LORAIN CO.  
MAP DEPT.  
DATE 6-6-68  
19-F  
BY  
K. Albert