


CT.

EDISON

WEST VIEW


TWP CITY

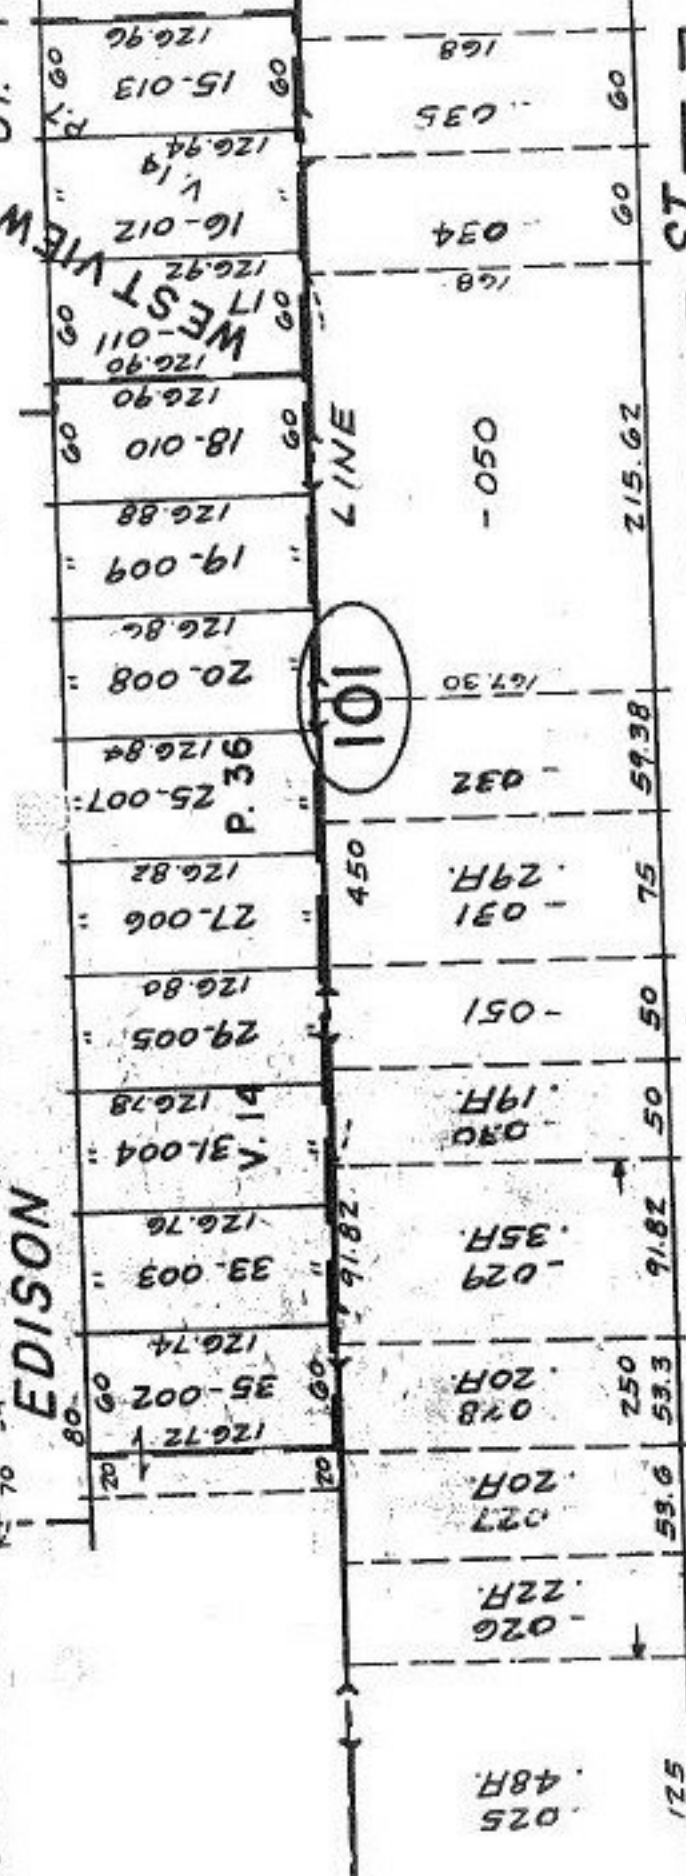

101

102

ST.

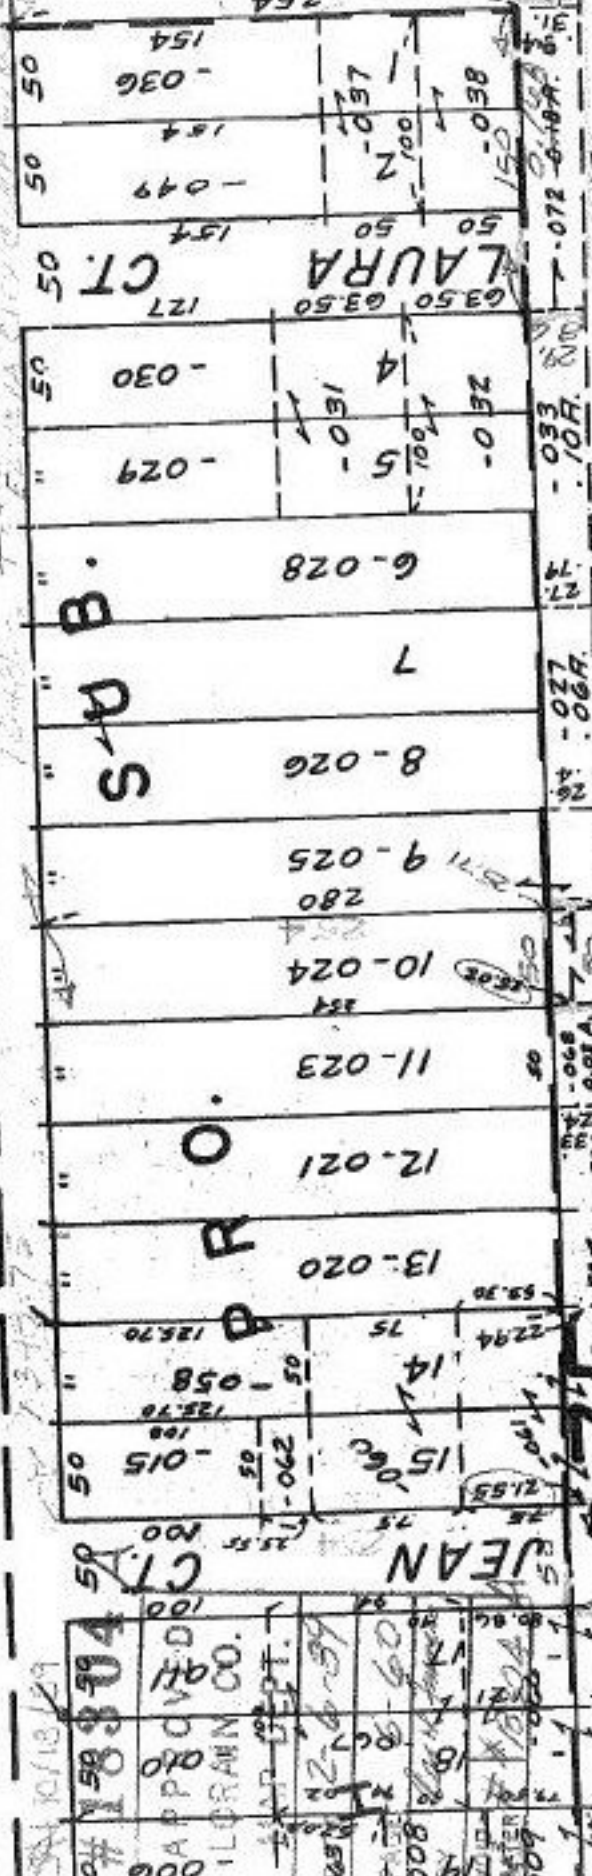

SUB.

PARO.

JEAN

LAURA

P. No. 13

Area = 1.25000

Area = 24390

Area = 24340

Acres Correction

As. Corr. See Survey By: LAUNDON SIMON & ASSOC.