


000 00.

RD. 60

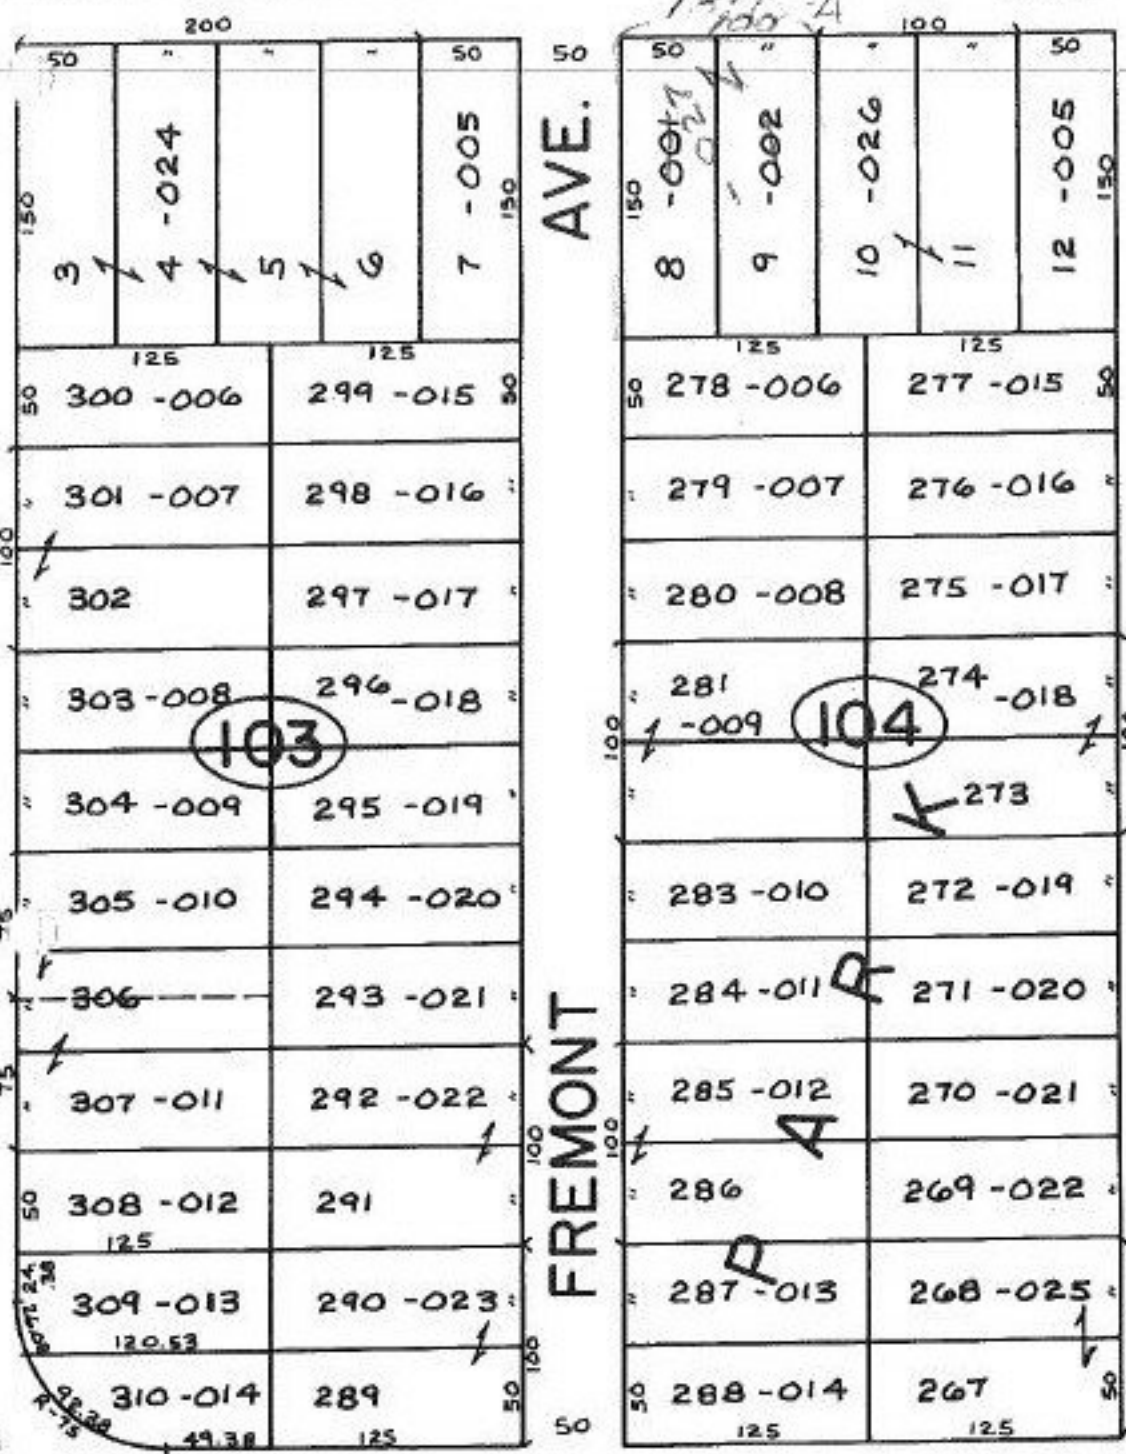

COMBINATION

12-00-020-104-001
002

3/24/89

#18315 A

APPROVED
LORAIN CO.
MAP DEPT.
DATE 2-7-89
PAGE 12-00-020-A
BY Carol L. Francis
VOID
AFTER #18315A

