

102

-001  
9.40F.

102


-001  
7.85F.

104

1045.90  
1024.72

COMBINATION

06-25-071-102-503-744-005

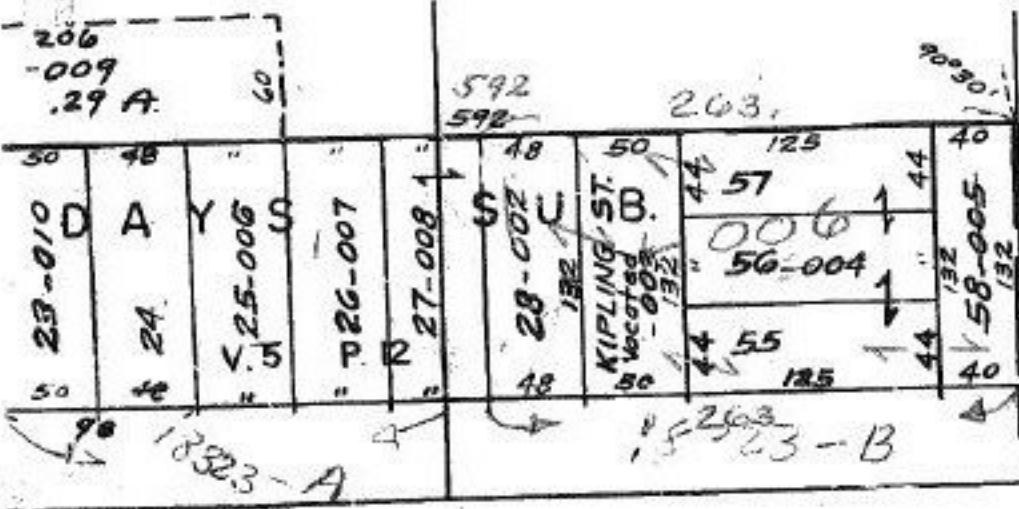

SEE 6 - 122

10/18/87  
#18323-B

EAST of RIVER S. LY PT. LOTS 34 THRU 38  
LY PT. LOT 16 ALL LOTS 67, 68, 69  
W. LY PT LOT 17 N. LY PT. LOTS 70, 71

APPROVED  
LORAIN CO.  
MAP DEPT.

DATE 2-24-89

PAGE 6-104

BY Carol Francis

VOID  
AFTER #18323B