


#18324-A

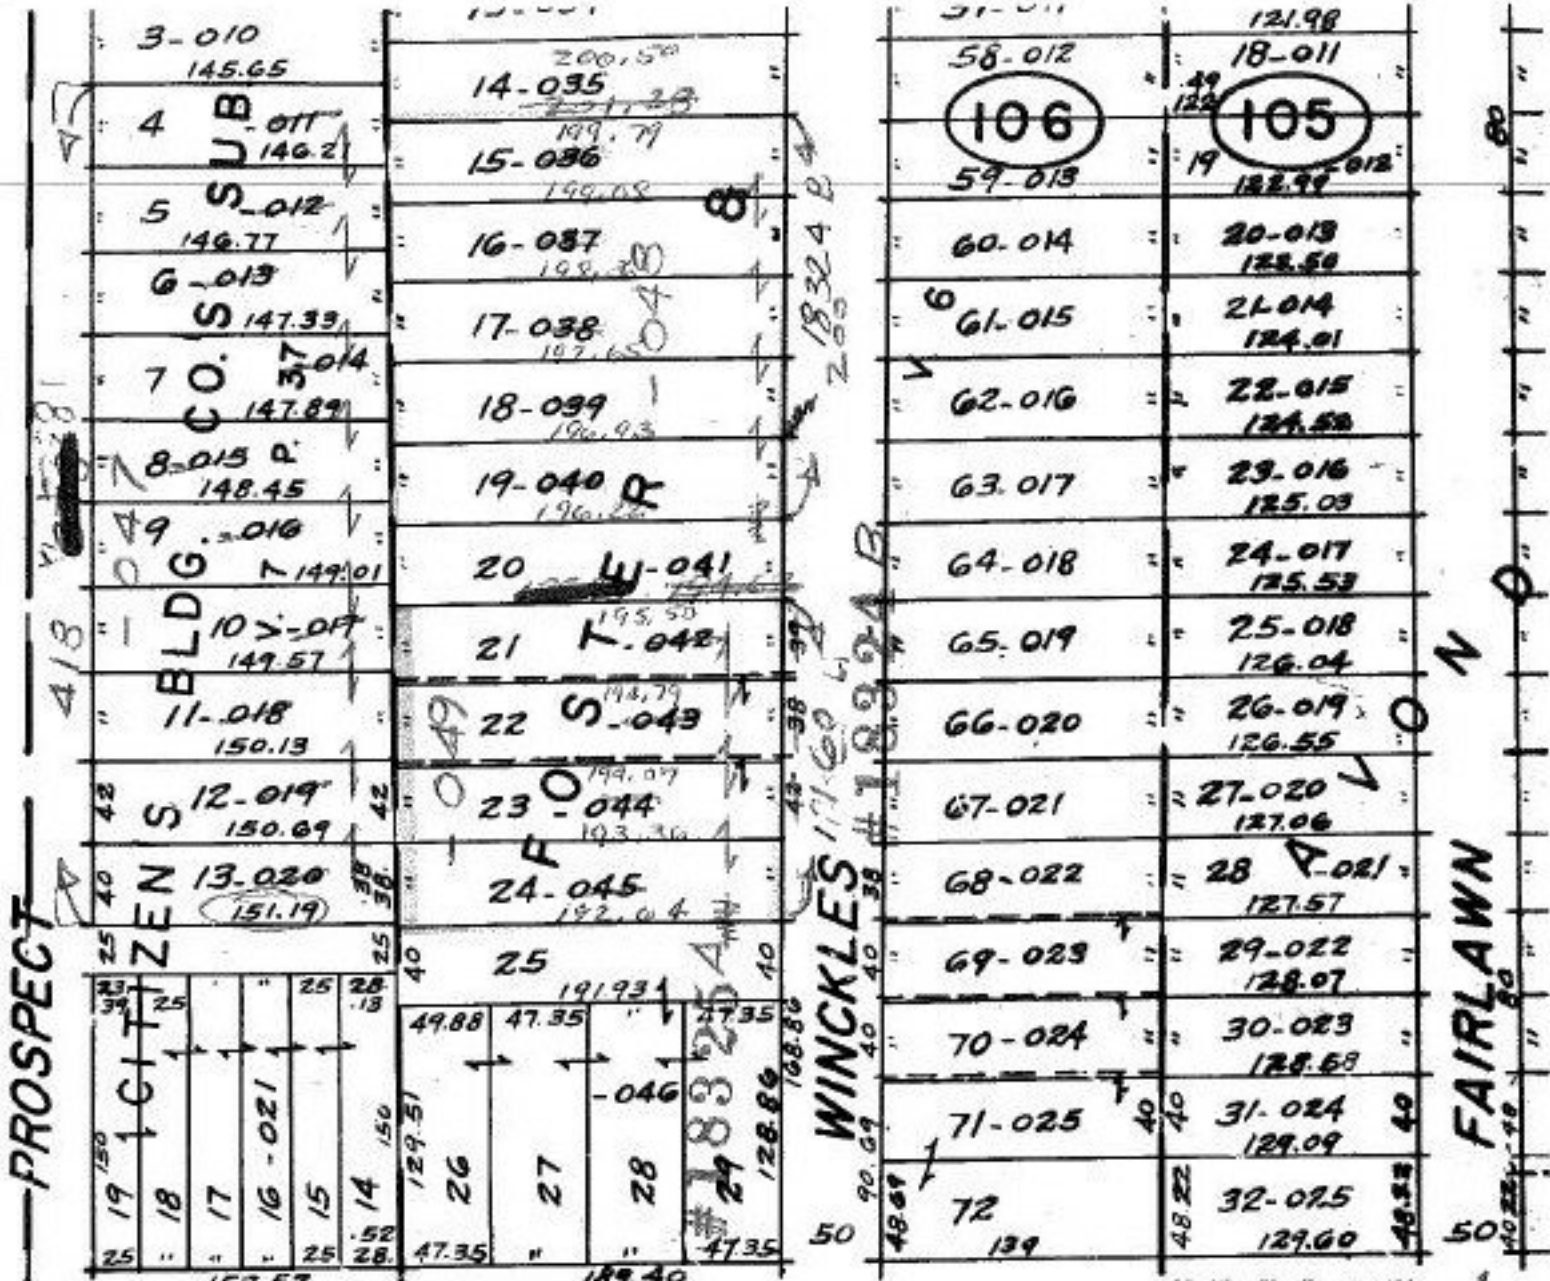

CLARK

#18325 A

#18324 B

10/18/89

#18324 A

EAST of RIVER NW-LY PT. LOT 14, N-LY PT. LC
 NE-LY PT. LOT 16, SE-LY PT. LC
 S-LY PT. LOT 18, SW-LY PT. LC

COMBINATION

DATE	2-24-89
PAGE	6-105
BY	Caul Francis
VOID AFTER #	18324A

#18324 (A) 06-25-016-105-041 Thru 020

(B) 06-25-016-105-036 thru 040

#18325 (A) 26-25-016-105-042 thru 045