


71

COMBINE

(A) 06-25-071-103-021-003

(B) 06-25-016-107-004-1114

113, 018  
512

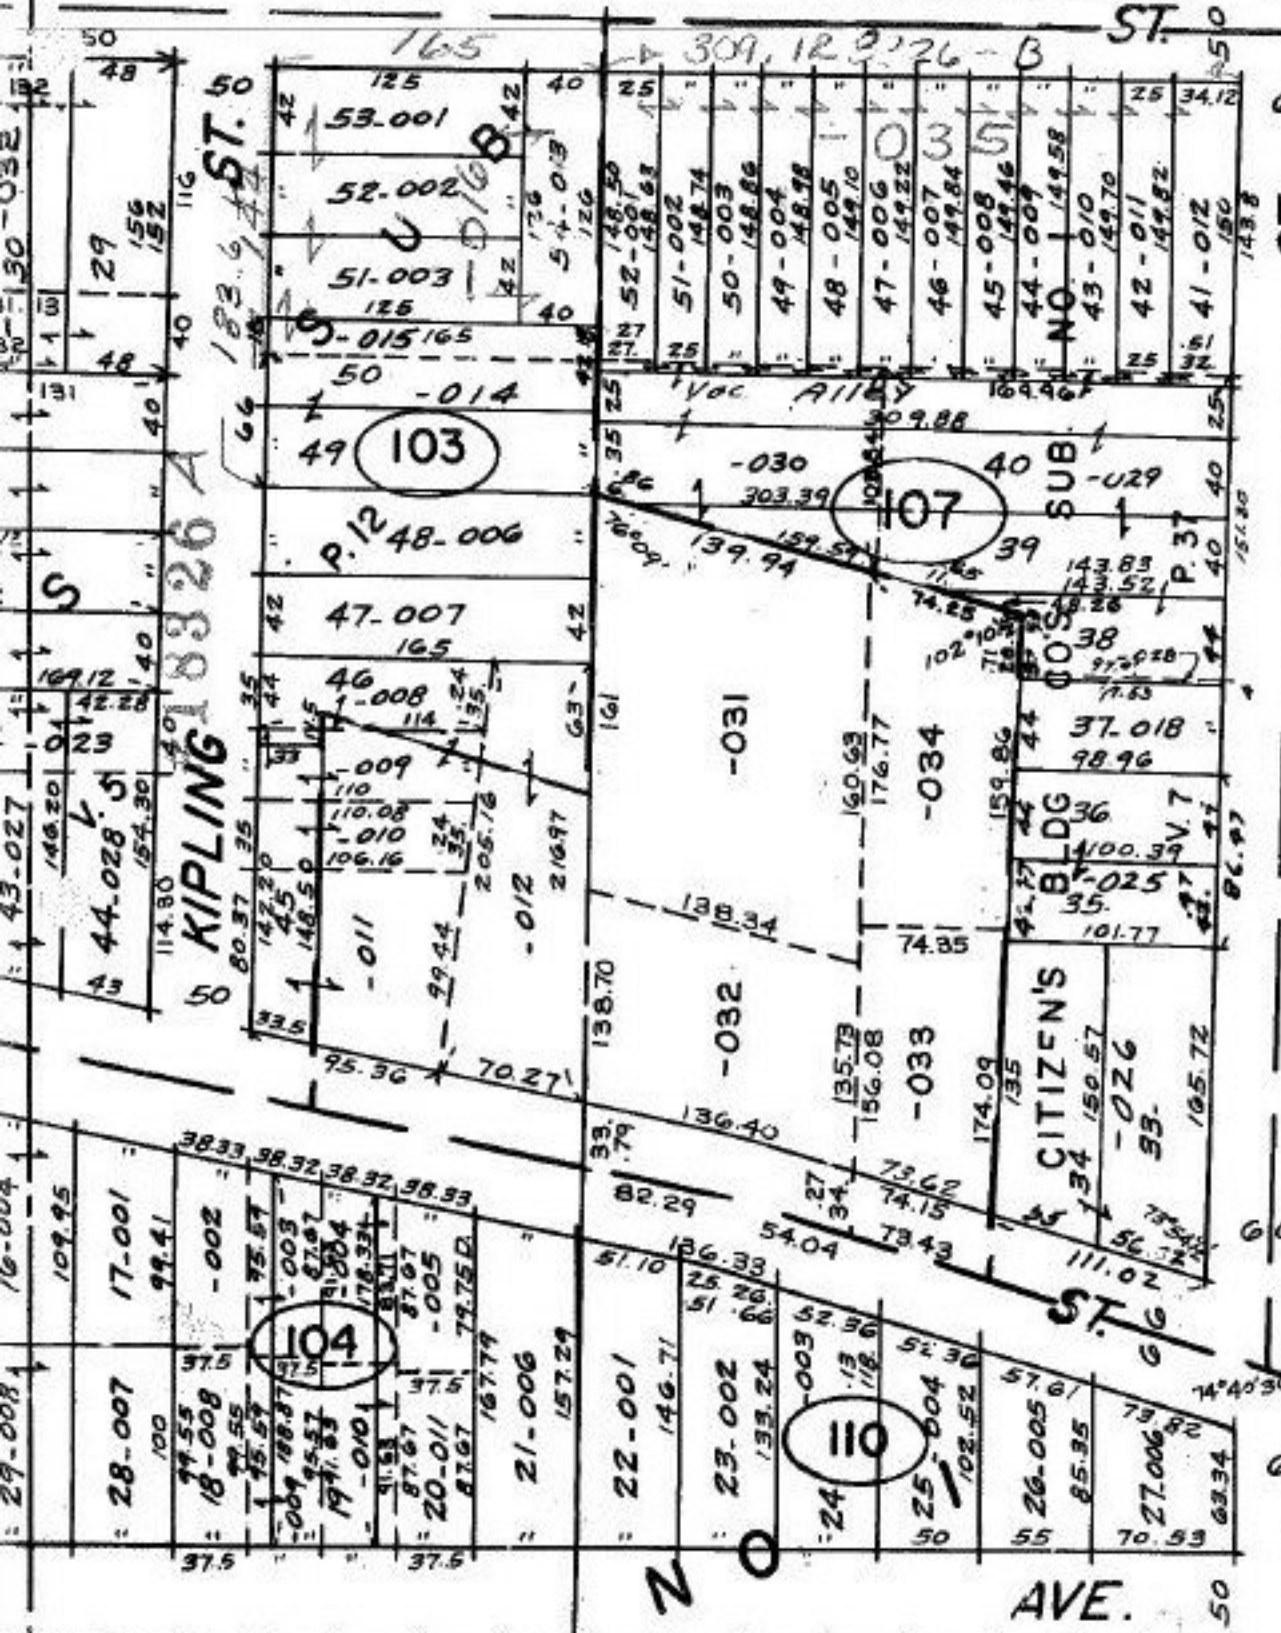

ST. 0  
ST. 6  
#18326-B

COMBINATION

16

#18326 B  
10/18/89  
#18326 A

APPROVED  
LORAIN CO.  
MAP DEPT.

DATE 2-24-89

RADE Lot 122

61 Carl Francis

VOID  
METER # 18326 A