


To Place
of beginning
see
SPUT # 8788
Creation of -058

SEE 7-00-027-B

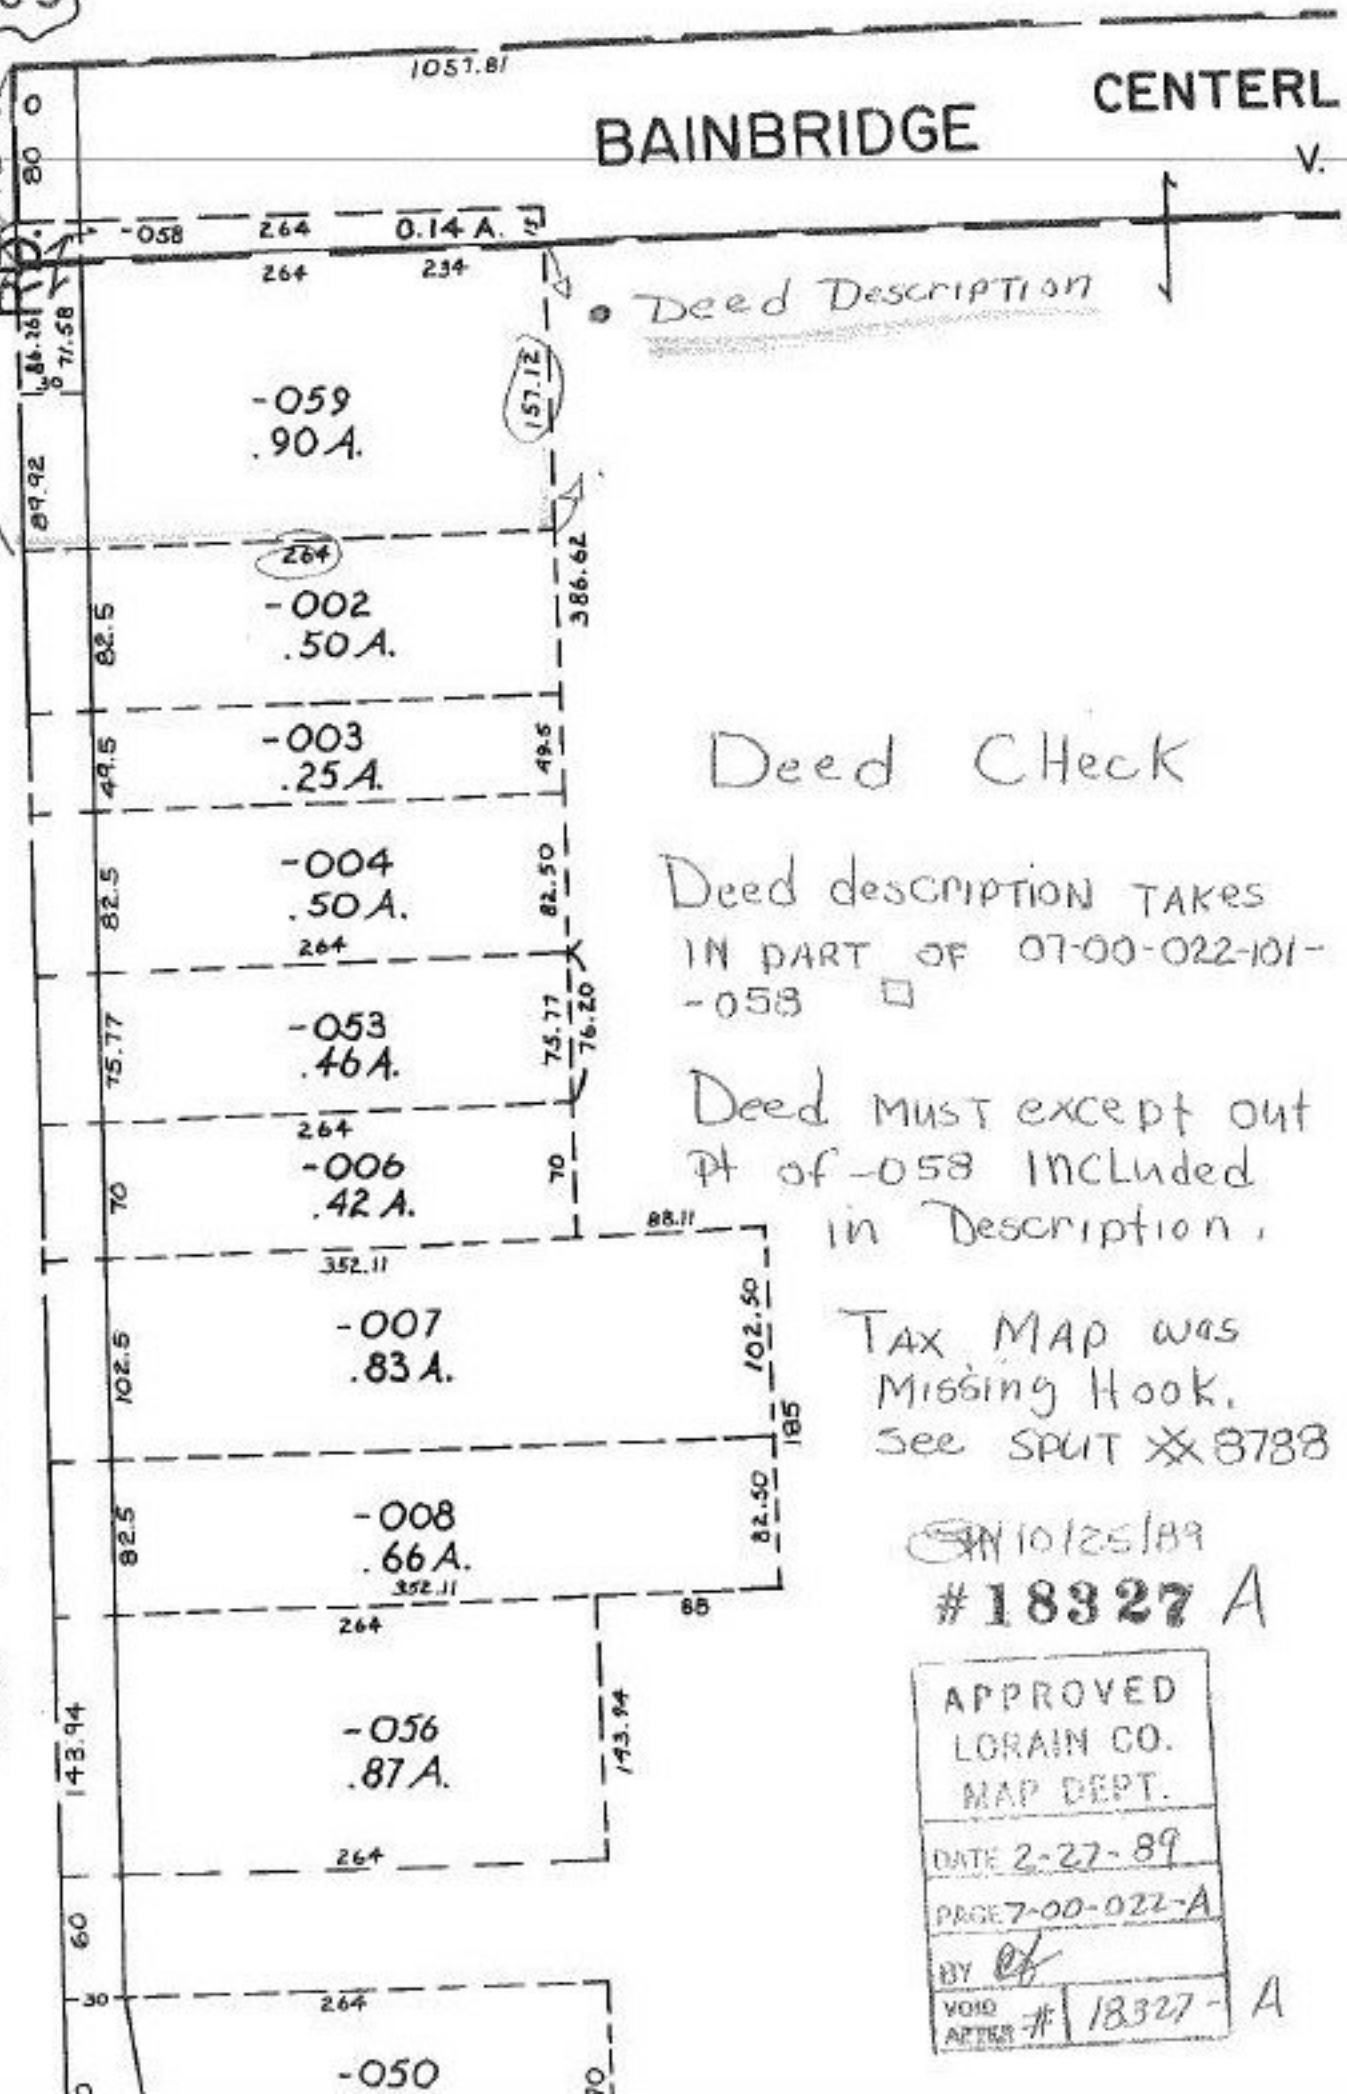

BAINBRIDGE CENTERLINE

Deed Description

Deed Check

Deed description TAKES
IN PART OF 07-00-022-101-
-058

Deed must except out
pt of -058 INCLUDED
in Description.

Tax Map was
Missing Hook.
See SPUT # 8788

SN 10/25/89
18327 A

APPROVED LORAIN CO. MAP DEPT.	
DATE 2-27-89	
PAGE 7-00-022-A	
BY <i>[Signature]</i>	
VOID AFTER	# 18327 - A