


COOPER FOSTER PARK Co. C

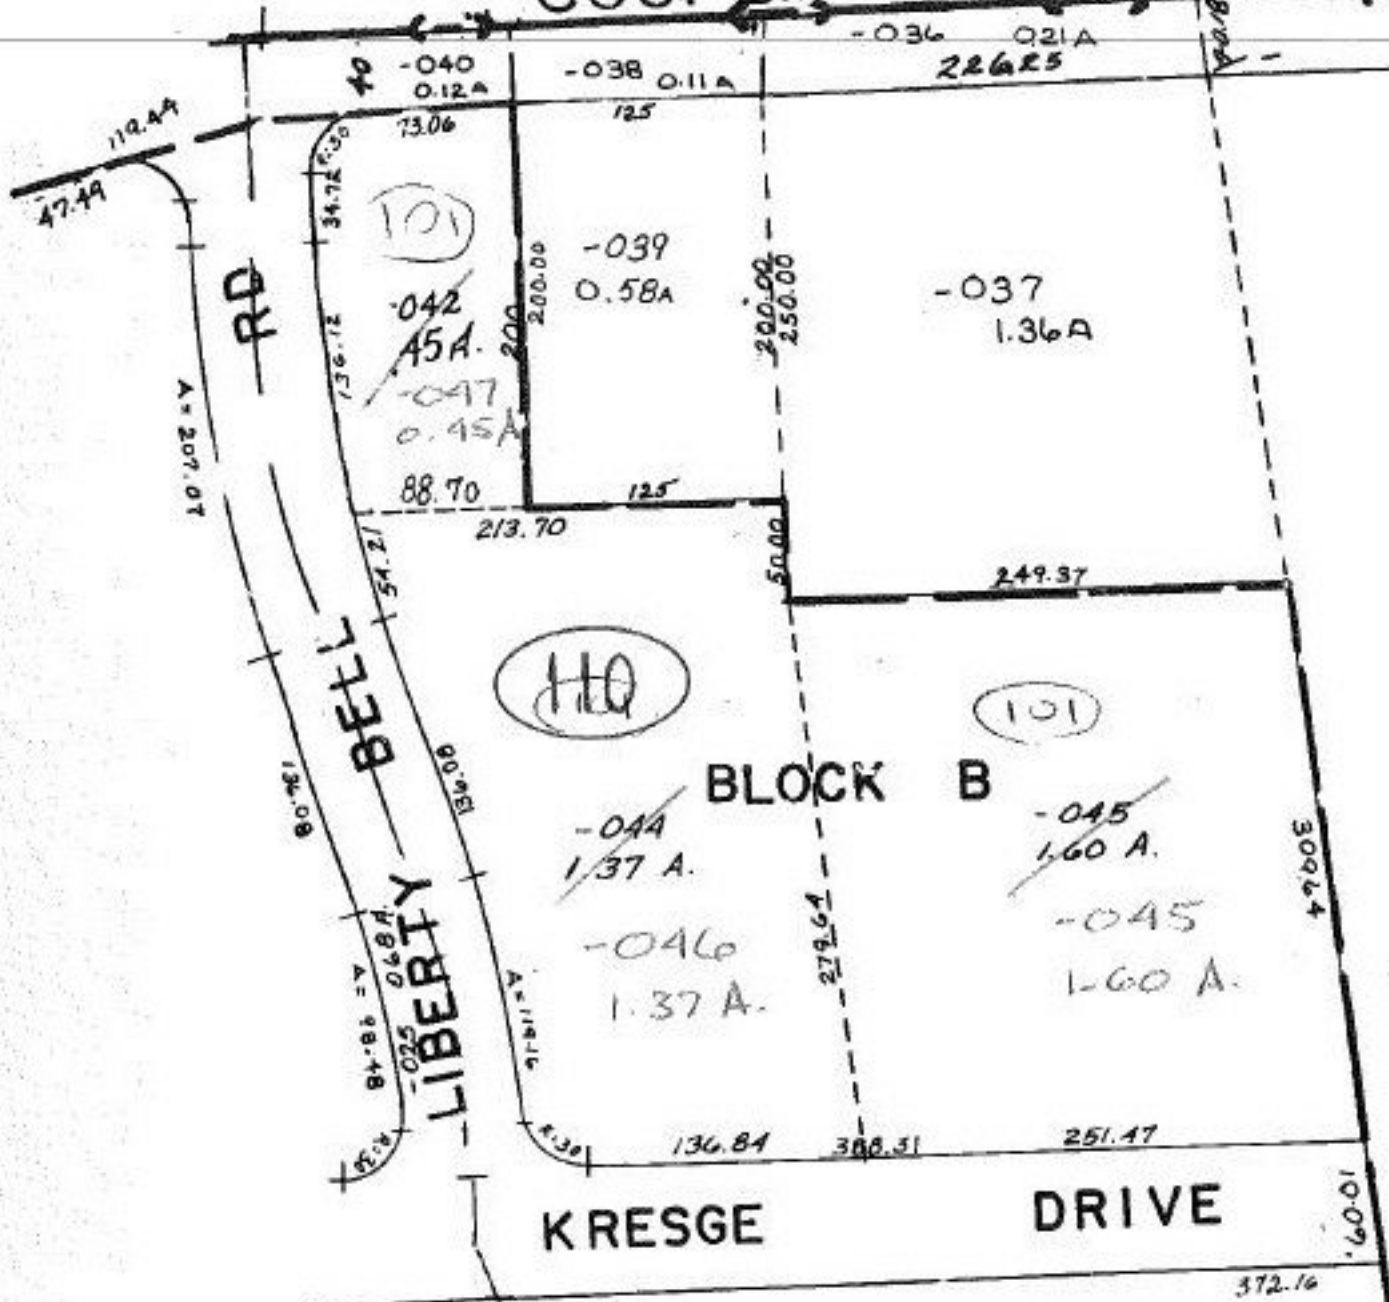

-033
PT. BLOCK D
10.14 A.

SEN 10/12/89
Bk. No. CORR.

#18349-A

APPROVED	
LORAIN CO.	
MAP DEPT.	
DATE 3-17-89	
PAGE 5-W-041-B	
BY	T. McMain
VOID AFTER	18349-A

10/9/15