


76-B

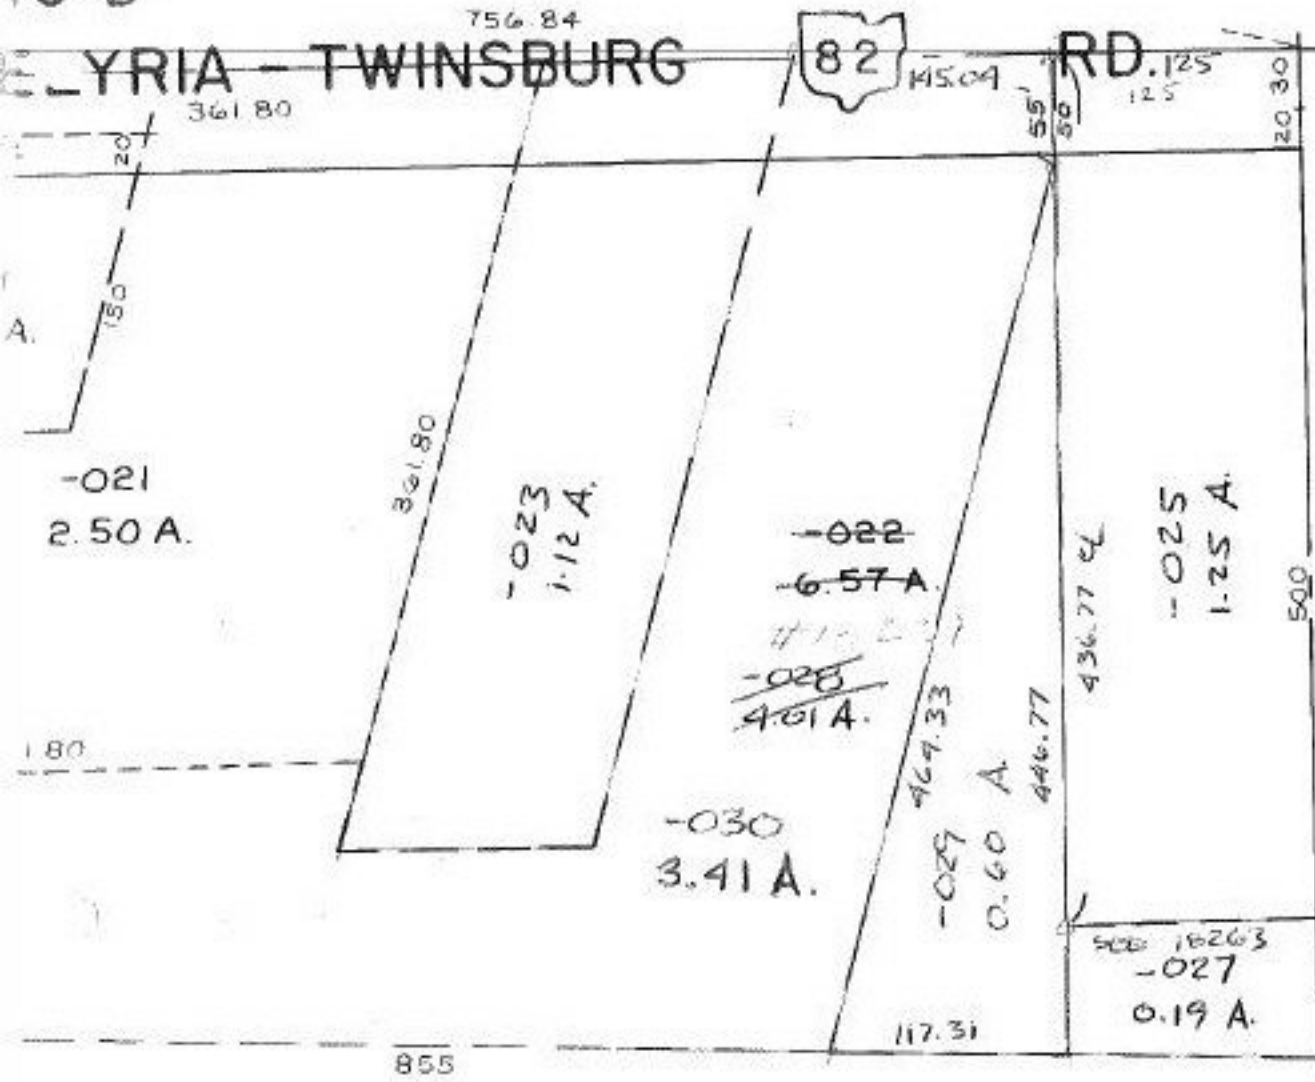

BOUNDARY SURVEY BY K.S. ASSOC
 SEE MAP CC 1:1000,000
 PRIOR INST. - OR 158/790

104

-017
18.52 A.

SH 10/26/89
#18353

APPROVED
 LORAIN CO.
 MAP DEPT.
 DATE 3-20-89
 PAGE 1200-075-B
 BY T. McMain
 VOID AFTER 18353

3459