



-001
4.75 A.

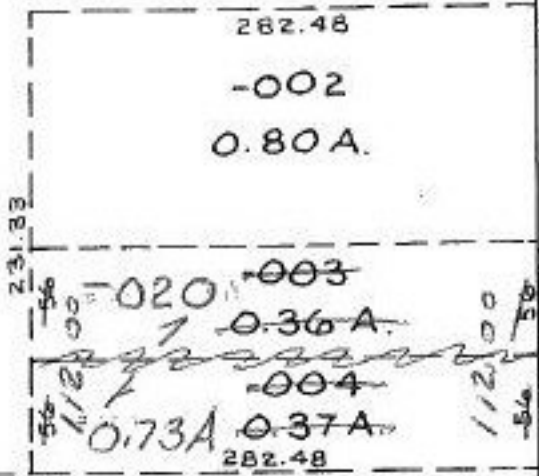

-019
4.90 A.

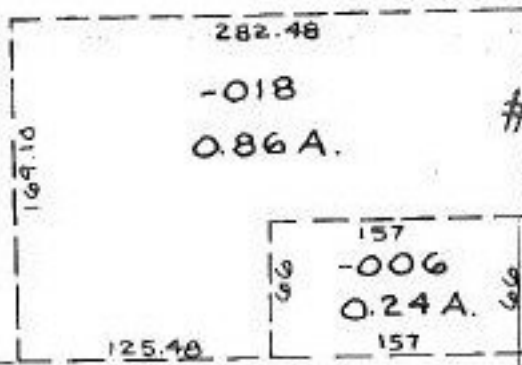

1107.47

155

-010

301

SEE 15-00-055-

COMBINATION

1500-056-105-003, 004

3129/89
8359A

APPROVED	
LORAIN CO.	
MAP DEPT.	
DATE	3-28-89
PAGE	15-00-056B
BY	CARDY FRANKS
VOID	
ACTED	18359A

6.32