


N. Y. C.  
100  
207.26  
66.70  
100  
37  
10

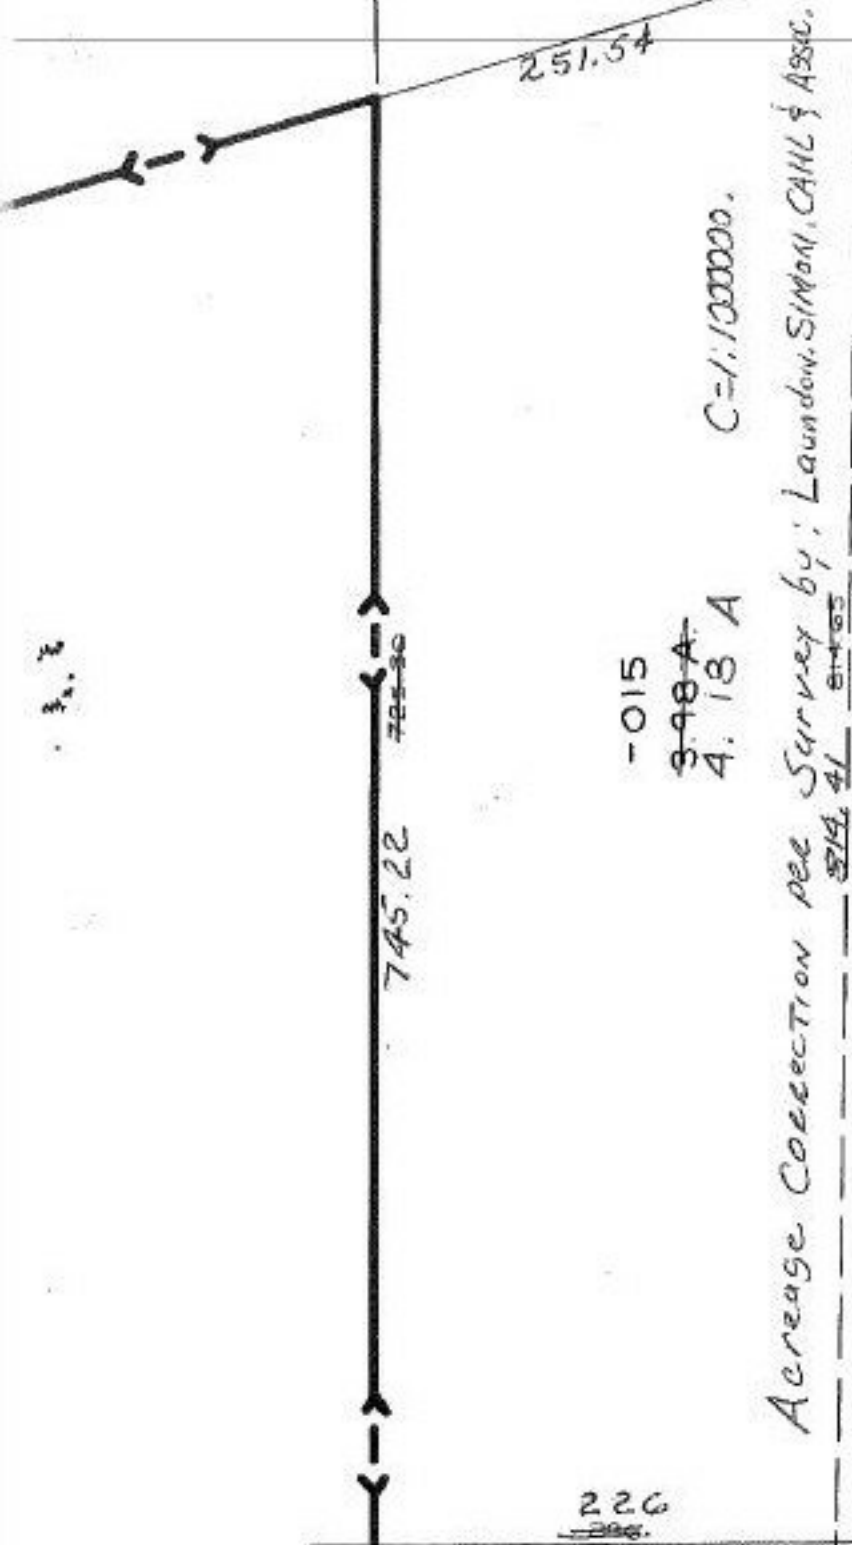

-015  
~~3-98-A~~  
4.18 A  
C=1:1000000.

(102)

-014  
3.83 A.

871.53  
873

-004  
2.04 A.

903  
556

Acreage Correction

SIN 10/26/89  
#18365A

HAMILTON

09-00-094-102-

APPROVED
LORAIN <sup>CC</sup>
MA <b>SEPT 9-00-</b>
DATE 3-29-89
PAGE 9-00-094-B
BY CAROL-FRANCIS
VOID METER # 18365-A