



Pt. -036 - 038
Pt. 44.62 A. 43.67-A

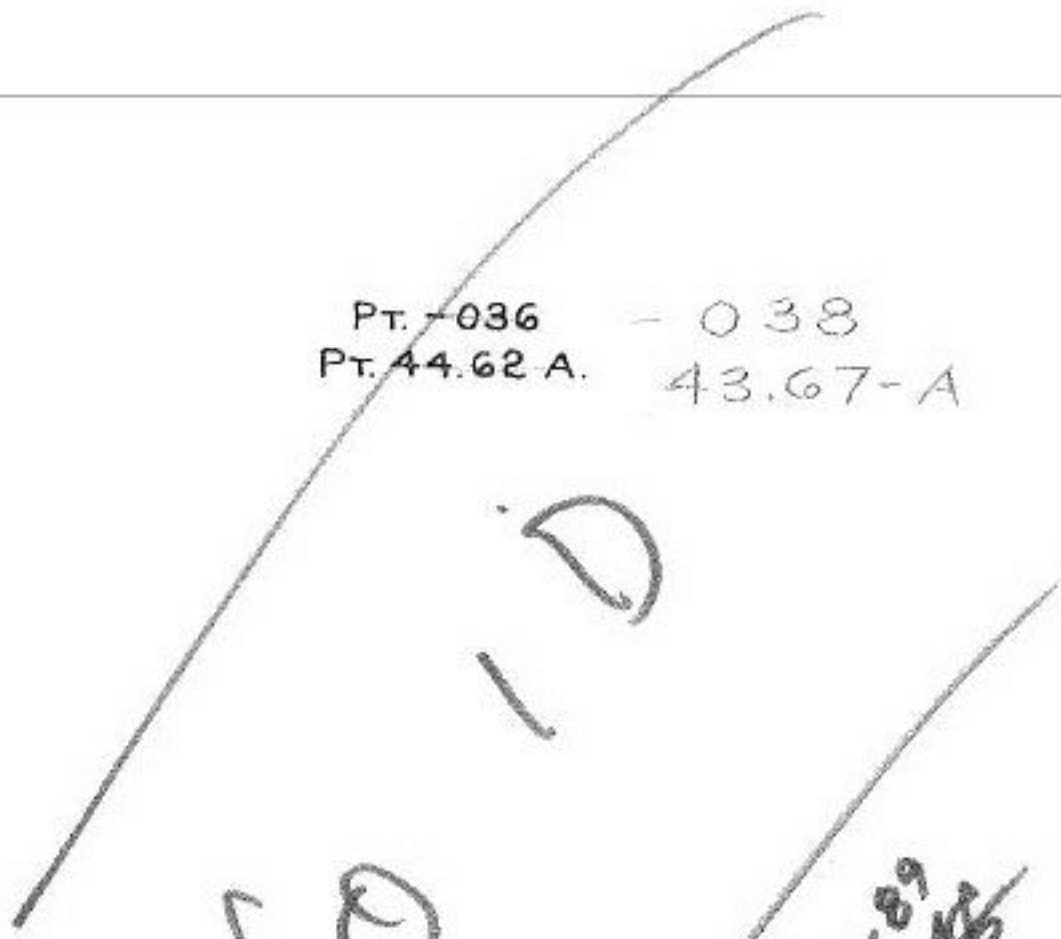

4-26-89
[Signature]

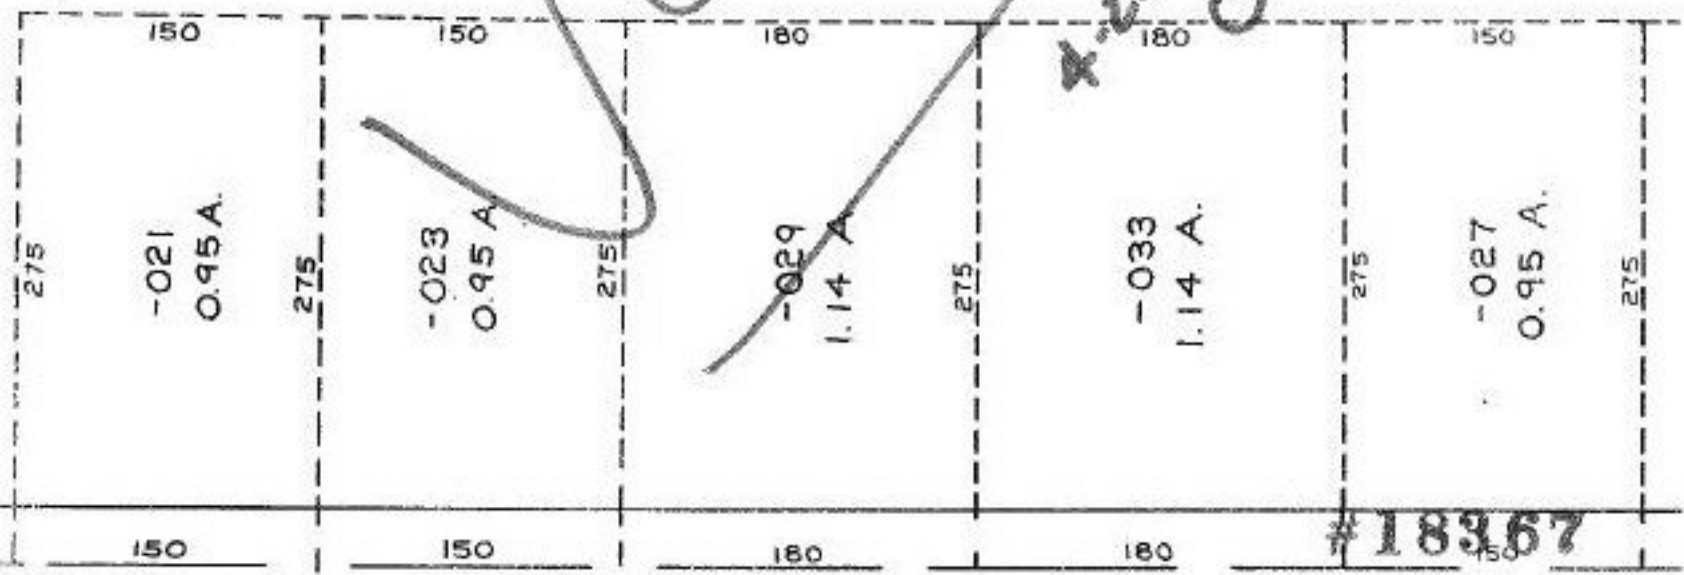

-021
0.95 A.

-023
0.95 A.

-029
1.14 A.

-033
1.14 A.

-027
0.95 A.

#18367

116

Pt. -020
Pt. 16.86 A.

OCT 26 1989
[Signature]

APPROVED
ORAIN CO.
MAP DEPT.
DATE 4-10-89
PAGE 10-00-015 G
BY CAROL FRANKS
VOID AFTER
18367