


76-B

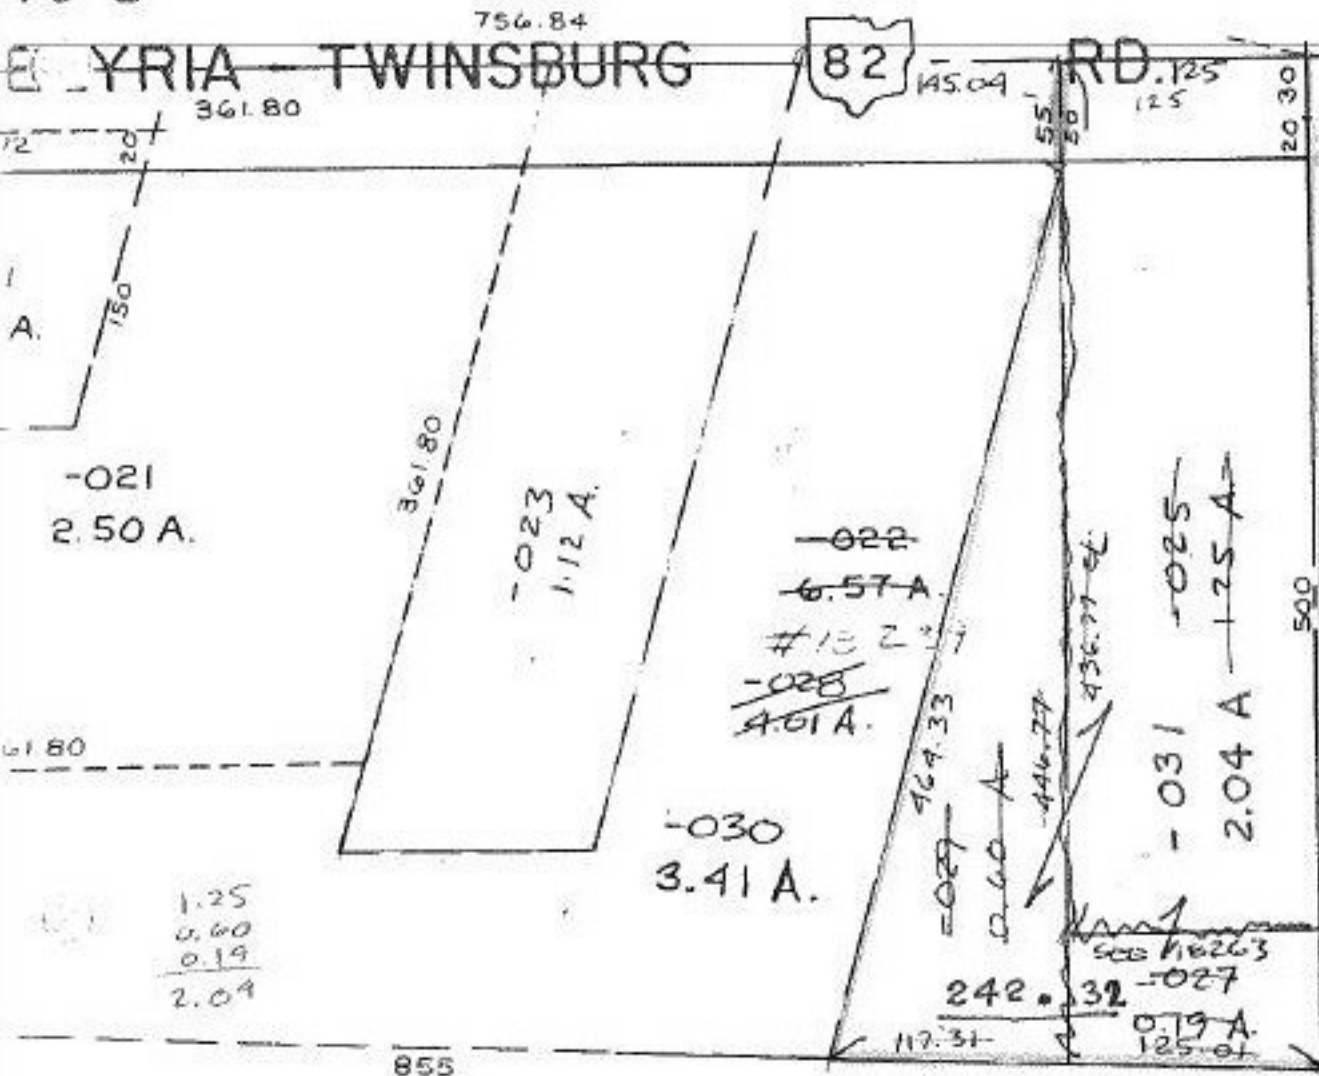

BOUNDARY SURVEY BY K.S. ASSOC
 SEE MAP CL 1:1000,000
 PRIOR INST. - OF 15B/790

10/26/89
 #18368-A

APPROVED
 LORAIN CO.
 MAP DEPT.
 DATE 4-5-89
 PAGE 12-00-075 B
 BY CAROL-FRANCIS
 VOID AFTER 18368-A

104

COMBINATION

12-00-075-104-025, 029, 027

-017
 18.52 A.

~~#18353~~
 APPROVED
 LORAIN CO.
 MAP DEPT.
 DATE 3-20-89
 PAGE 12-00-075-B
 BY T. McMain
 VOID AFTER 18353

34.56