
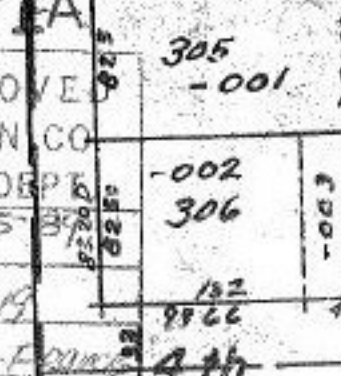
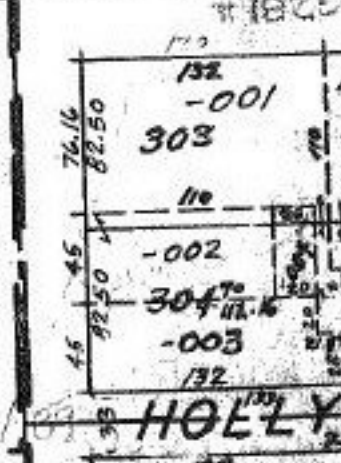
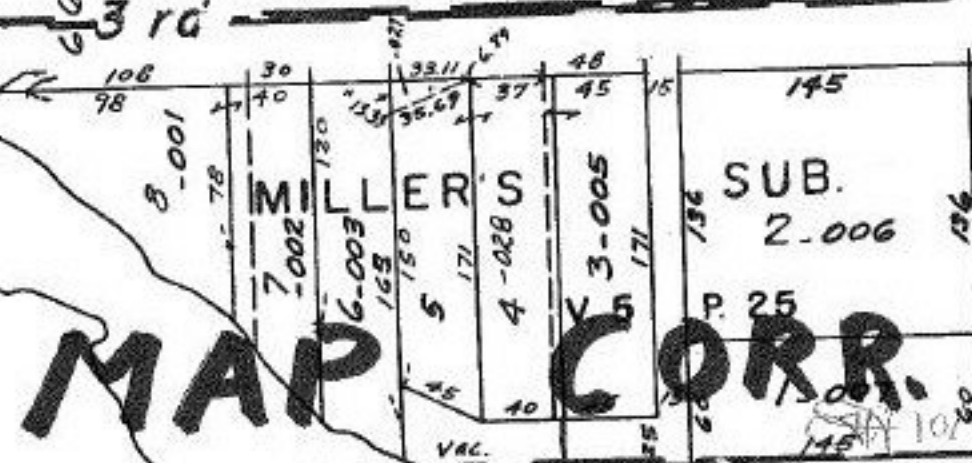
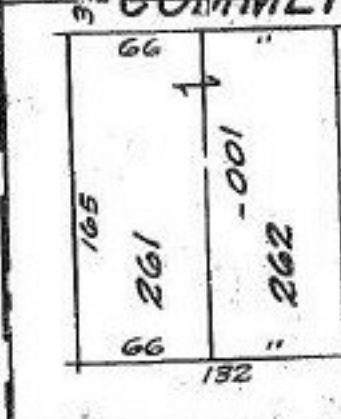
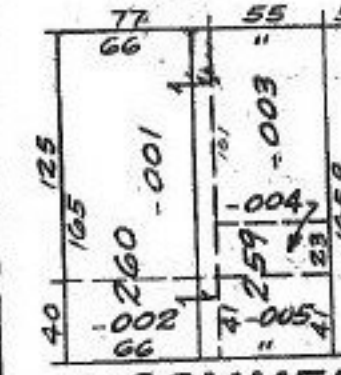
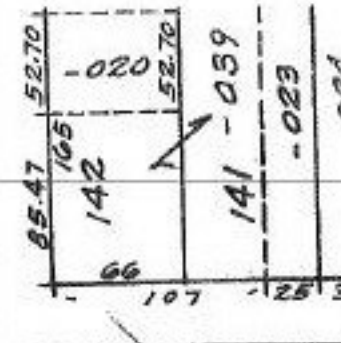
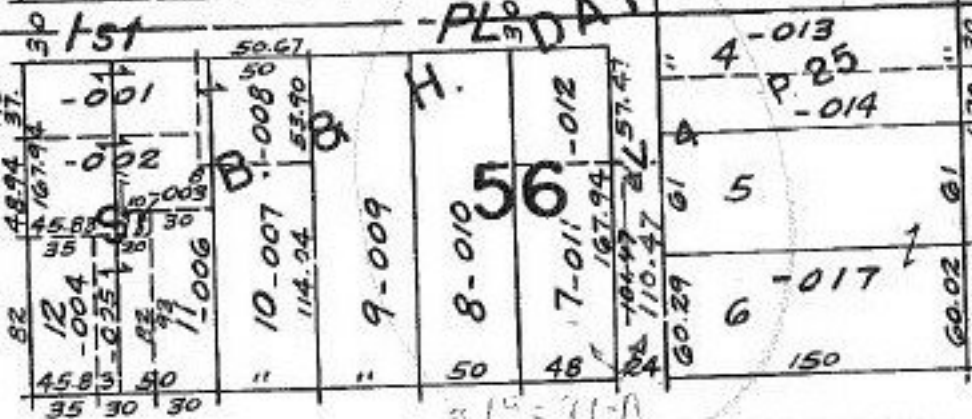
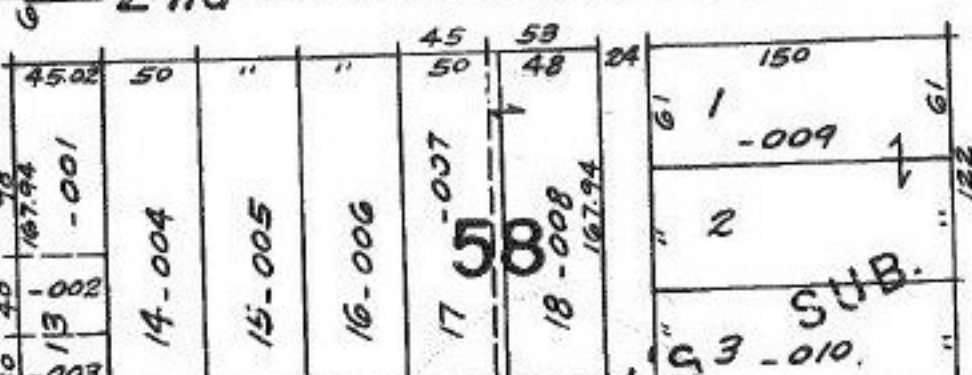


SEE 6-118

CHESTNUT

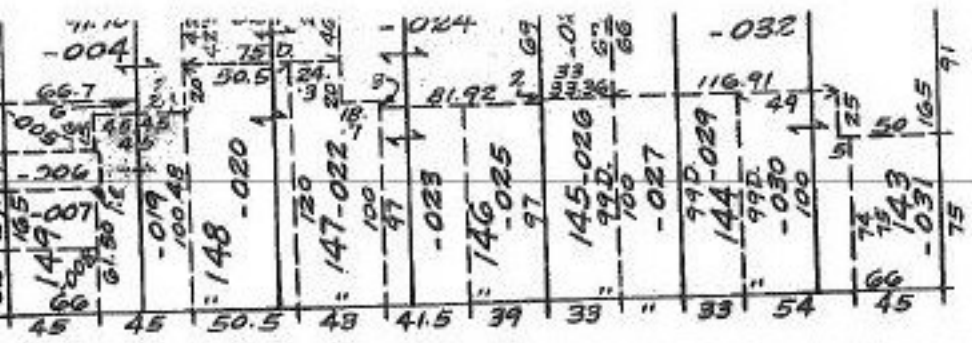

**MAP CORR.**

MILLER

SUB. 2-006

HOLLY

DEPTH CORRECTION PER. DEED VOL. 660/445

428 -009

APPROVE  
LORAIN CO  
MAP DEPT  
DATE  
PAGE 6-119  
BY  
VOID

#18971A

306

305

304

River