


NUMBERS 1 TO 10 ON THE ...
2599.23

471.24

REBARE
Fd

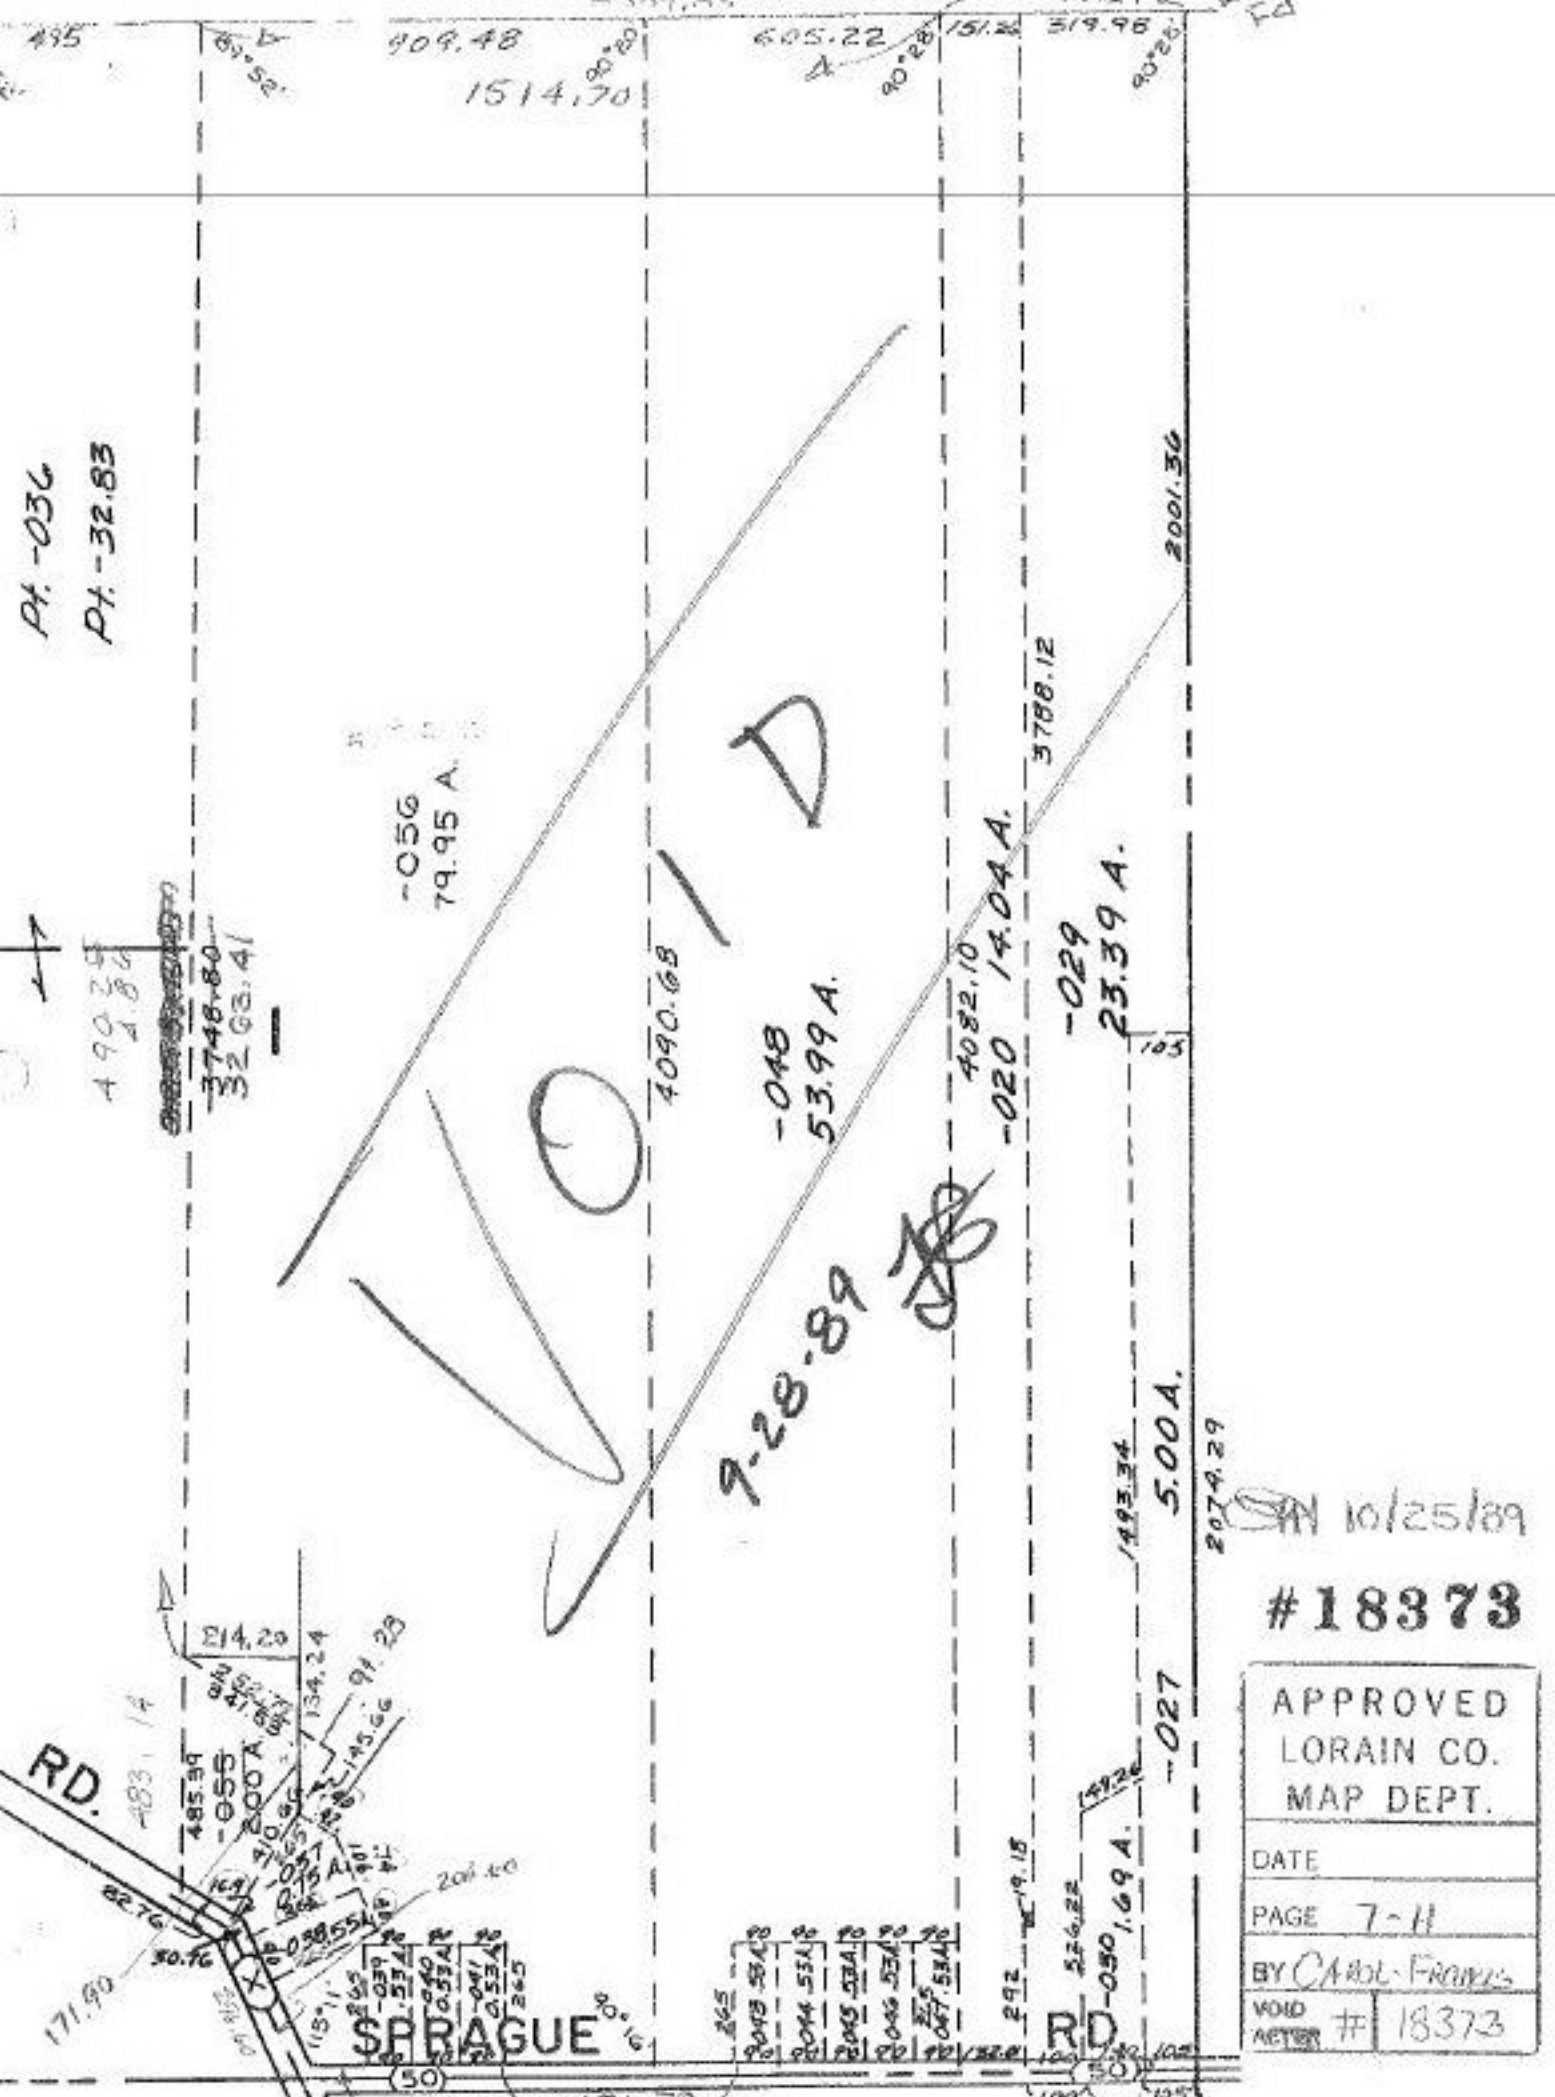

10/25/89

#18373

APPROVED LORAIN CO. MAP DEPT.	
DATE	
PAGE 7-H	
BY Carol Francis	
VOID ACTER	# 18373