


JAN

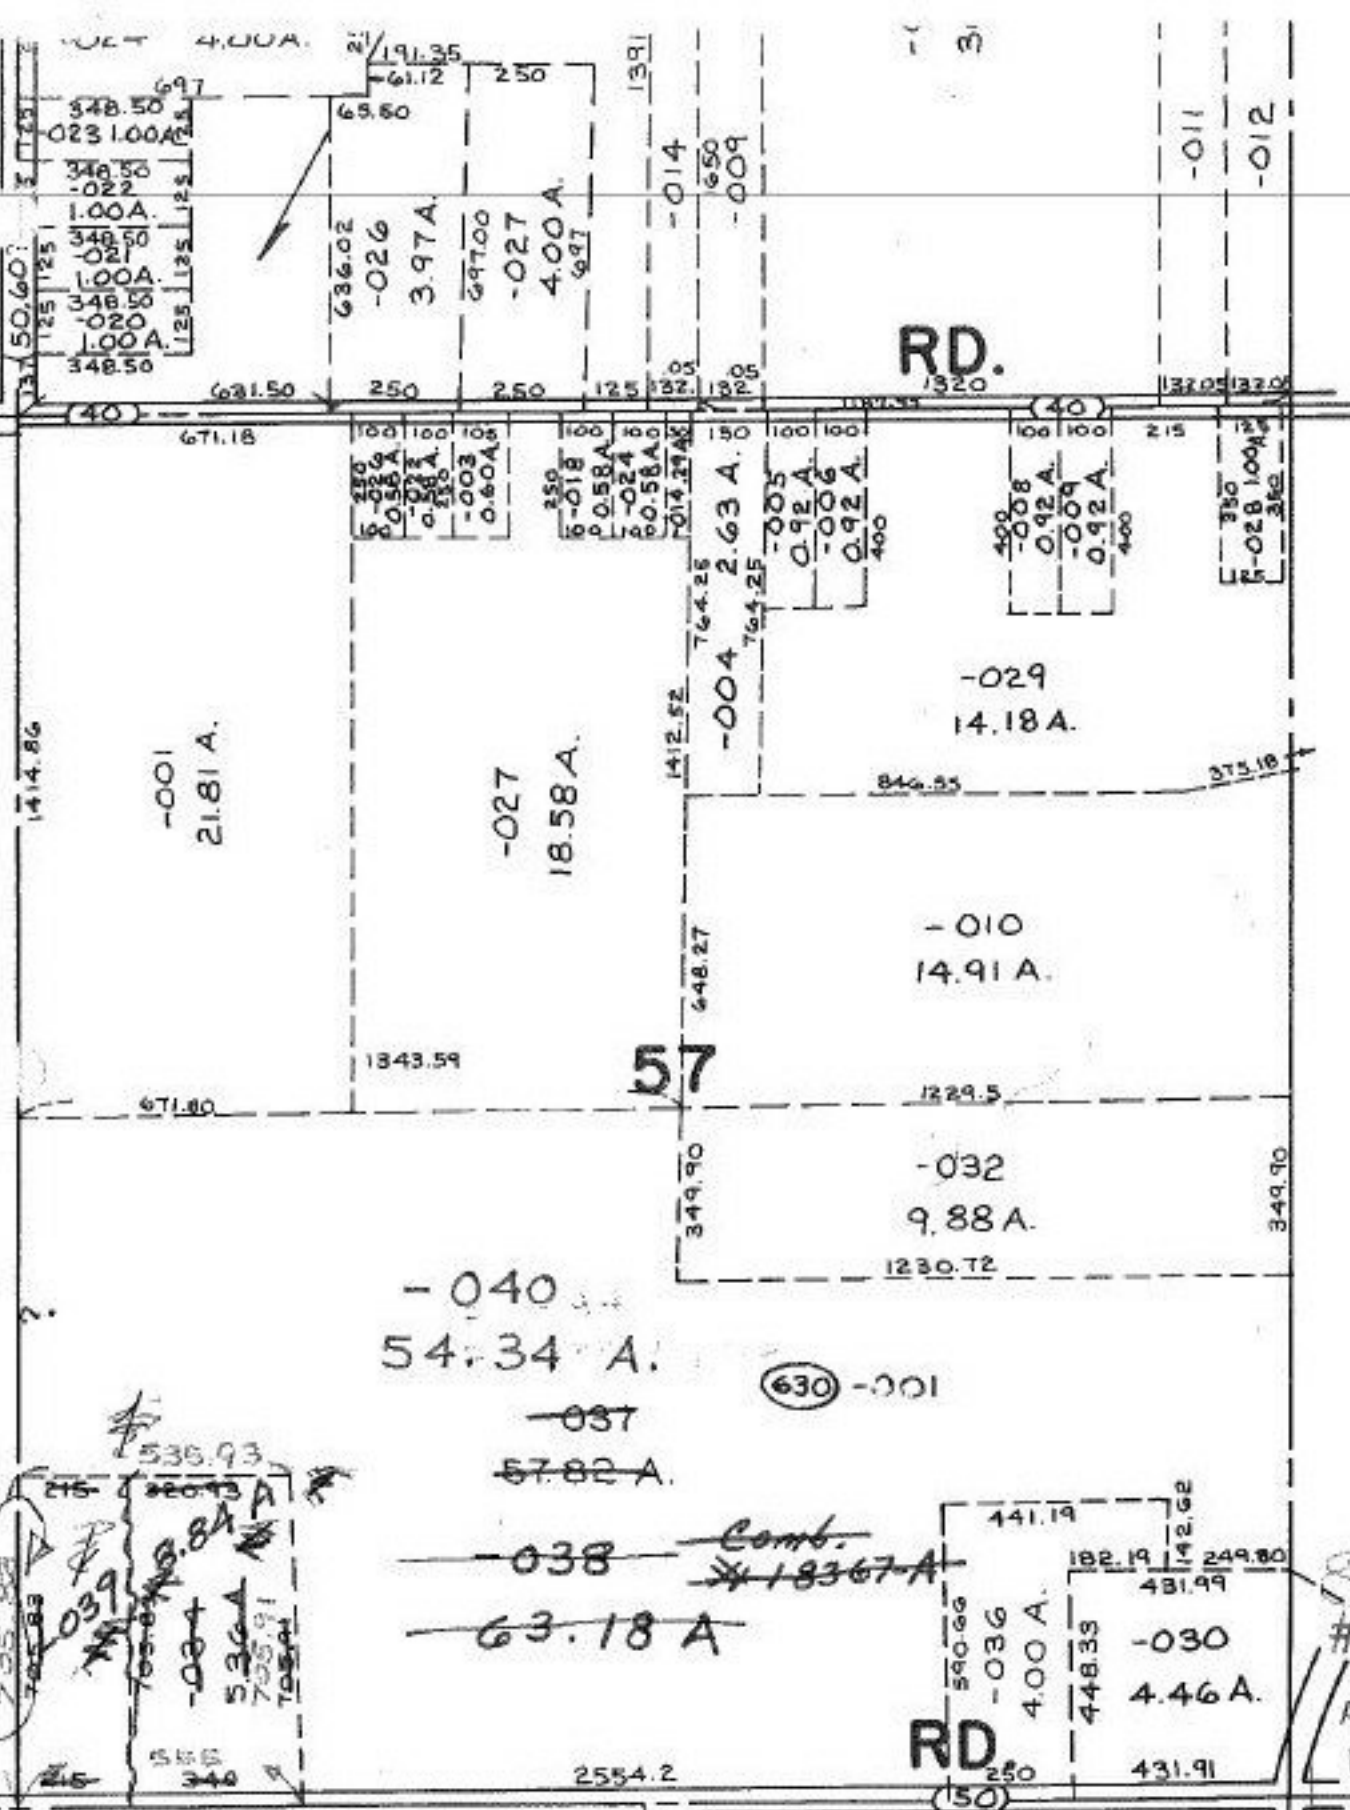

12-00-057-000-
 PRIOR INST. 1323/157
 SURVEYED BY: K.S. A.
 C-1:333333.

10/26/89
 # 18384

APPROVED
 LORAIN CO.
 MAP DEPT.

DATE 4-12-89
 PAGE 12-B
 BY CAROL-FRANCIS
 VOID AFTER # 18384

RD.

57

RD.

RD.