



E 4-00-027-E

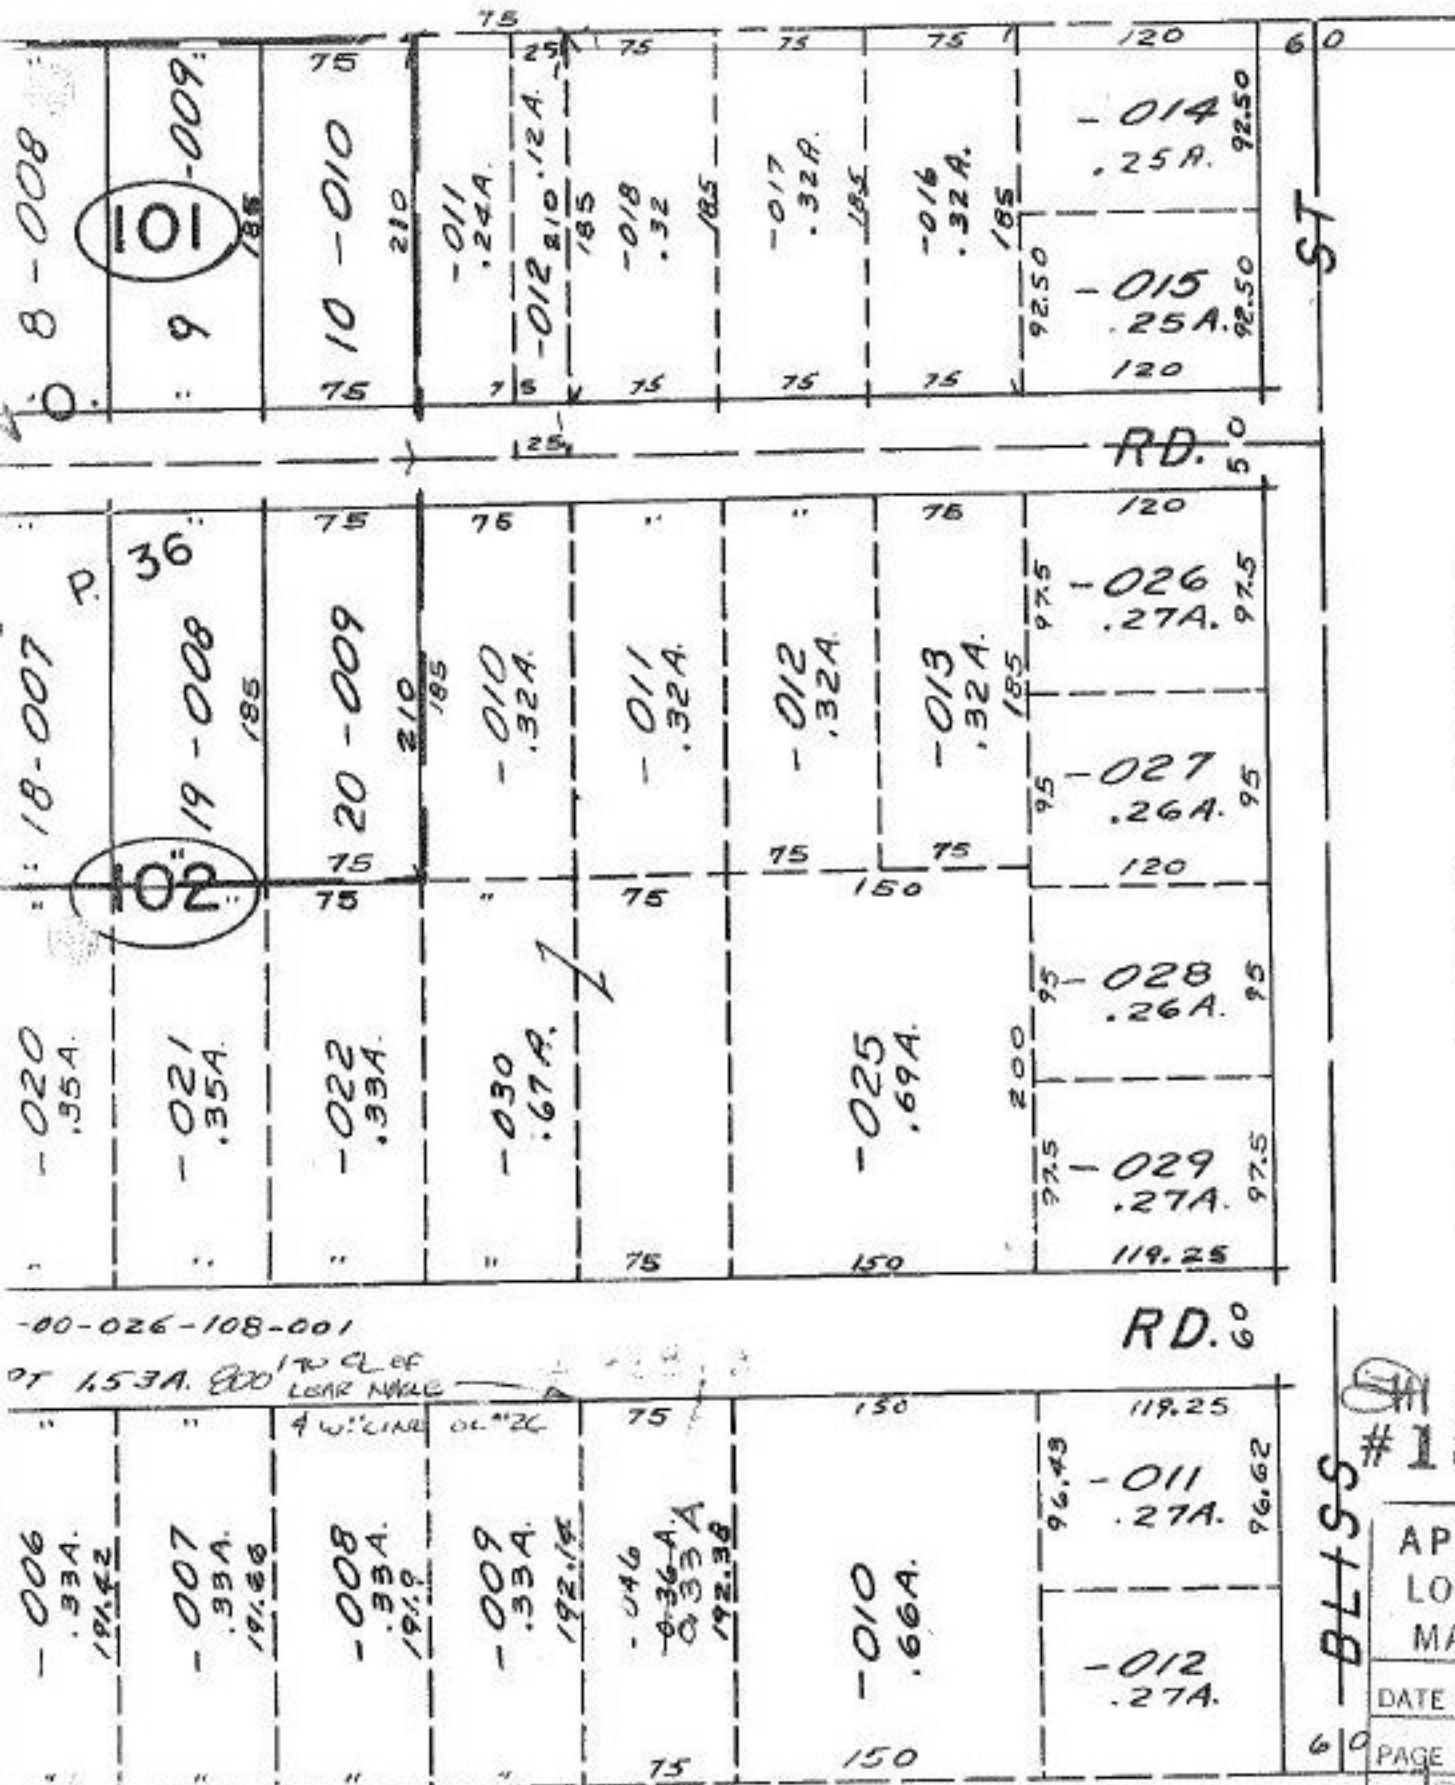

AC. CORR. ONLY -

-00-026-108-001

OT 153A. 800 1/2 CL OF LEAS. MARK

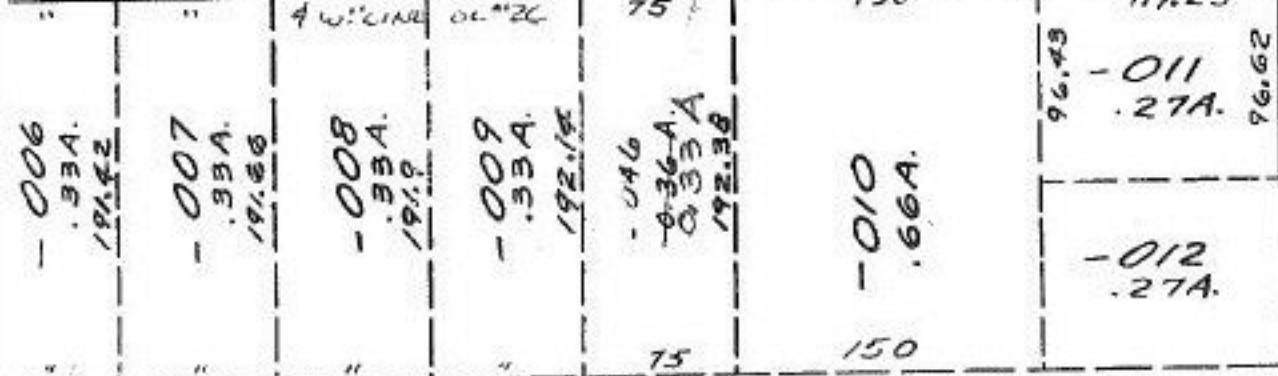

AC. CORR. PER DV. 623/22-PARCEL (4)

Dead surveyed by Warden's Assoc, (0) Degrees was missing on Deed, PARCEL Closed 1:250000

BLISS #18389 A

APPROVED
LORAIN CO.
MAP DEPT.

DATE 5-15-89

PAGE 4-00-026-A

BY Carol Frimas

VOID AFTER # 18389 A