


SEE 10-00-024-D

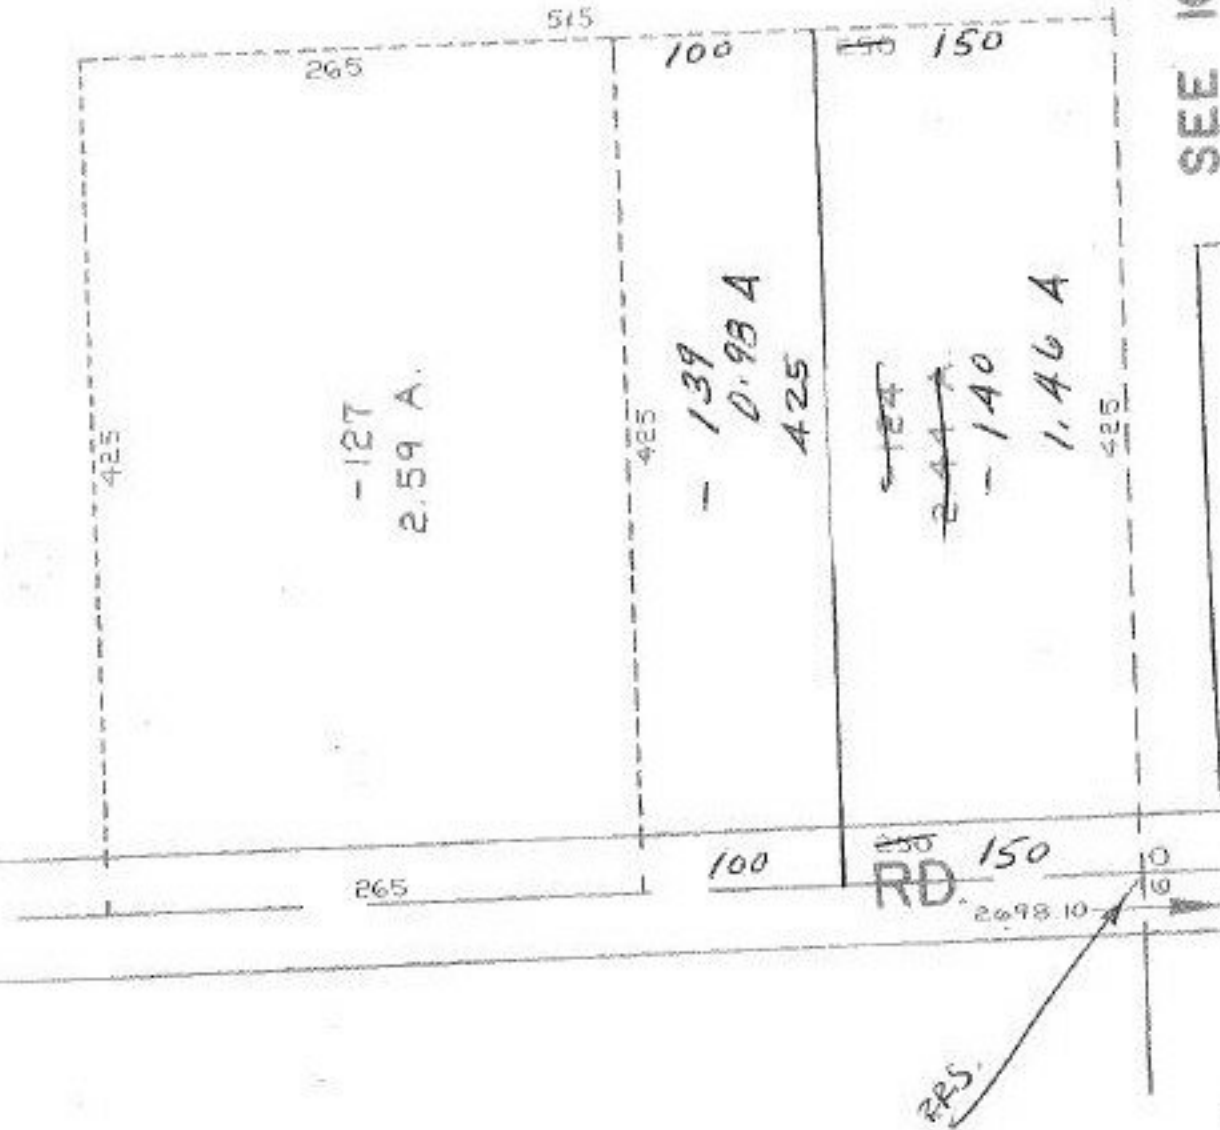

10-00-024-000-
 PRIOR INST. O.R. 39/480
 SURVEYED BY: K S ASSOC.
 C-1: INF.

10/27/89
 #18395

APPROVED
 LORAIN CO.
 MAP DEPT.

DATE 4-21-89

PAGE 10-00-024-C

BY CAROL FRANKS

VOID AFTER #18395