


18-00-016-B

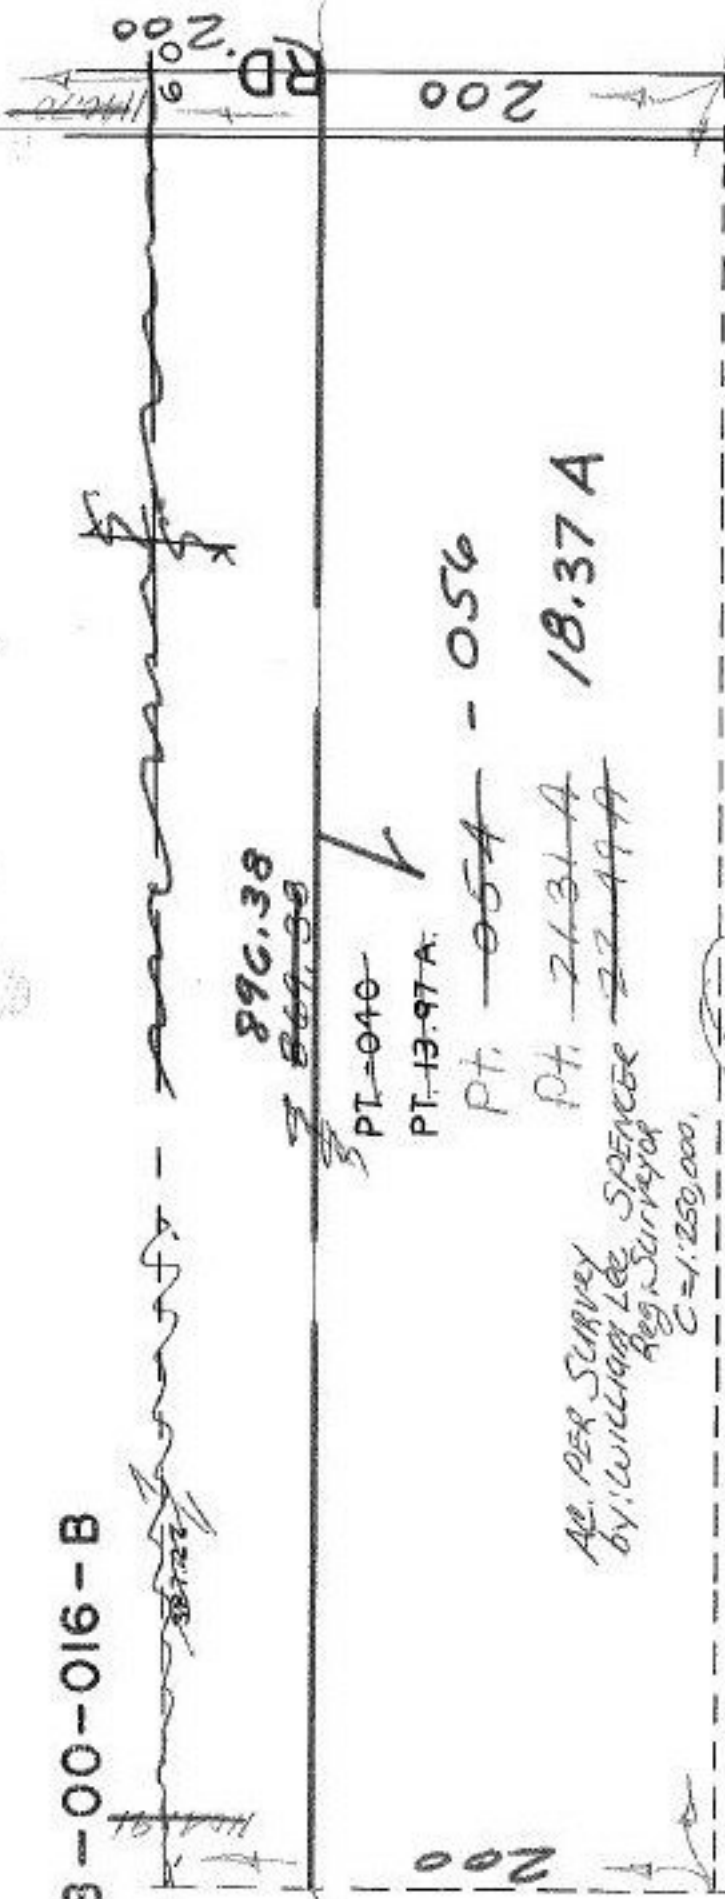

PT-040

PT-13-97A

PT-054 - 056

PT-2131A 18.37 A


AC. PER SURVEY
 BY WILLIAM LEE SPENCER
 Reg. Surveyor
 C=1:250,000

896.42

COMBINATION & SPLIT

12/29/89
 #18396

APPROVED™
LORAIN CO. B
MAP DEPT.
DATE 5-23-89
PAGE 1800-0162
BY <i>Carroll Jones</i>
VOID METER # 18396

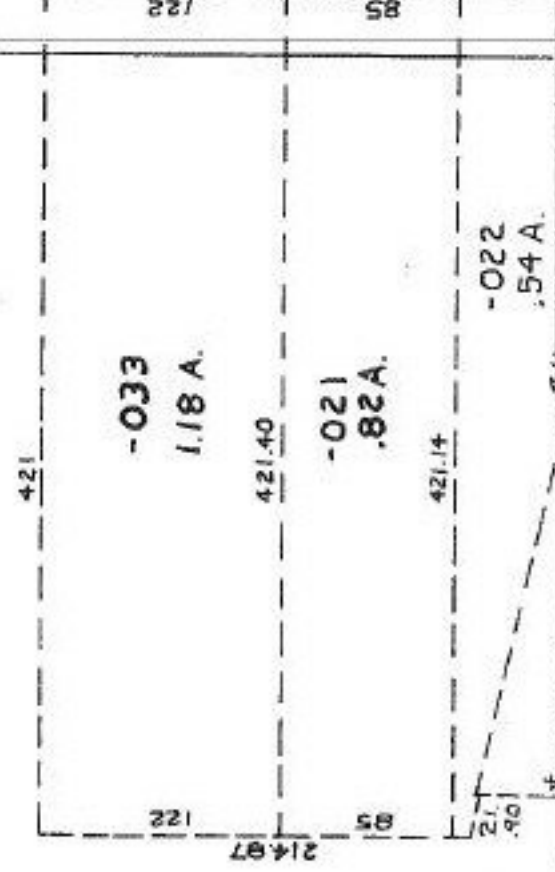

-039