


GREEN

1564.93

1284.63

STIP

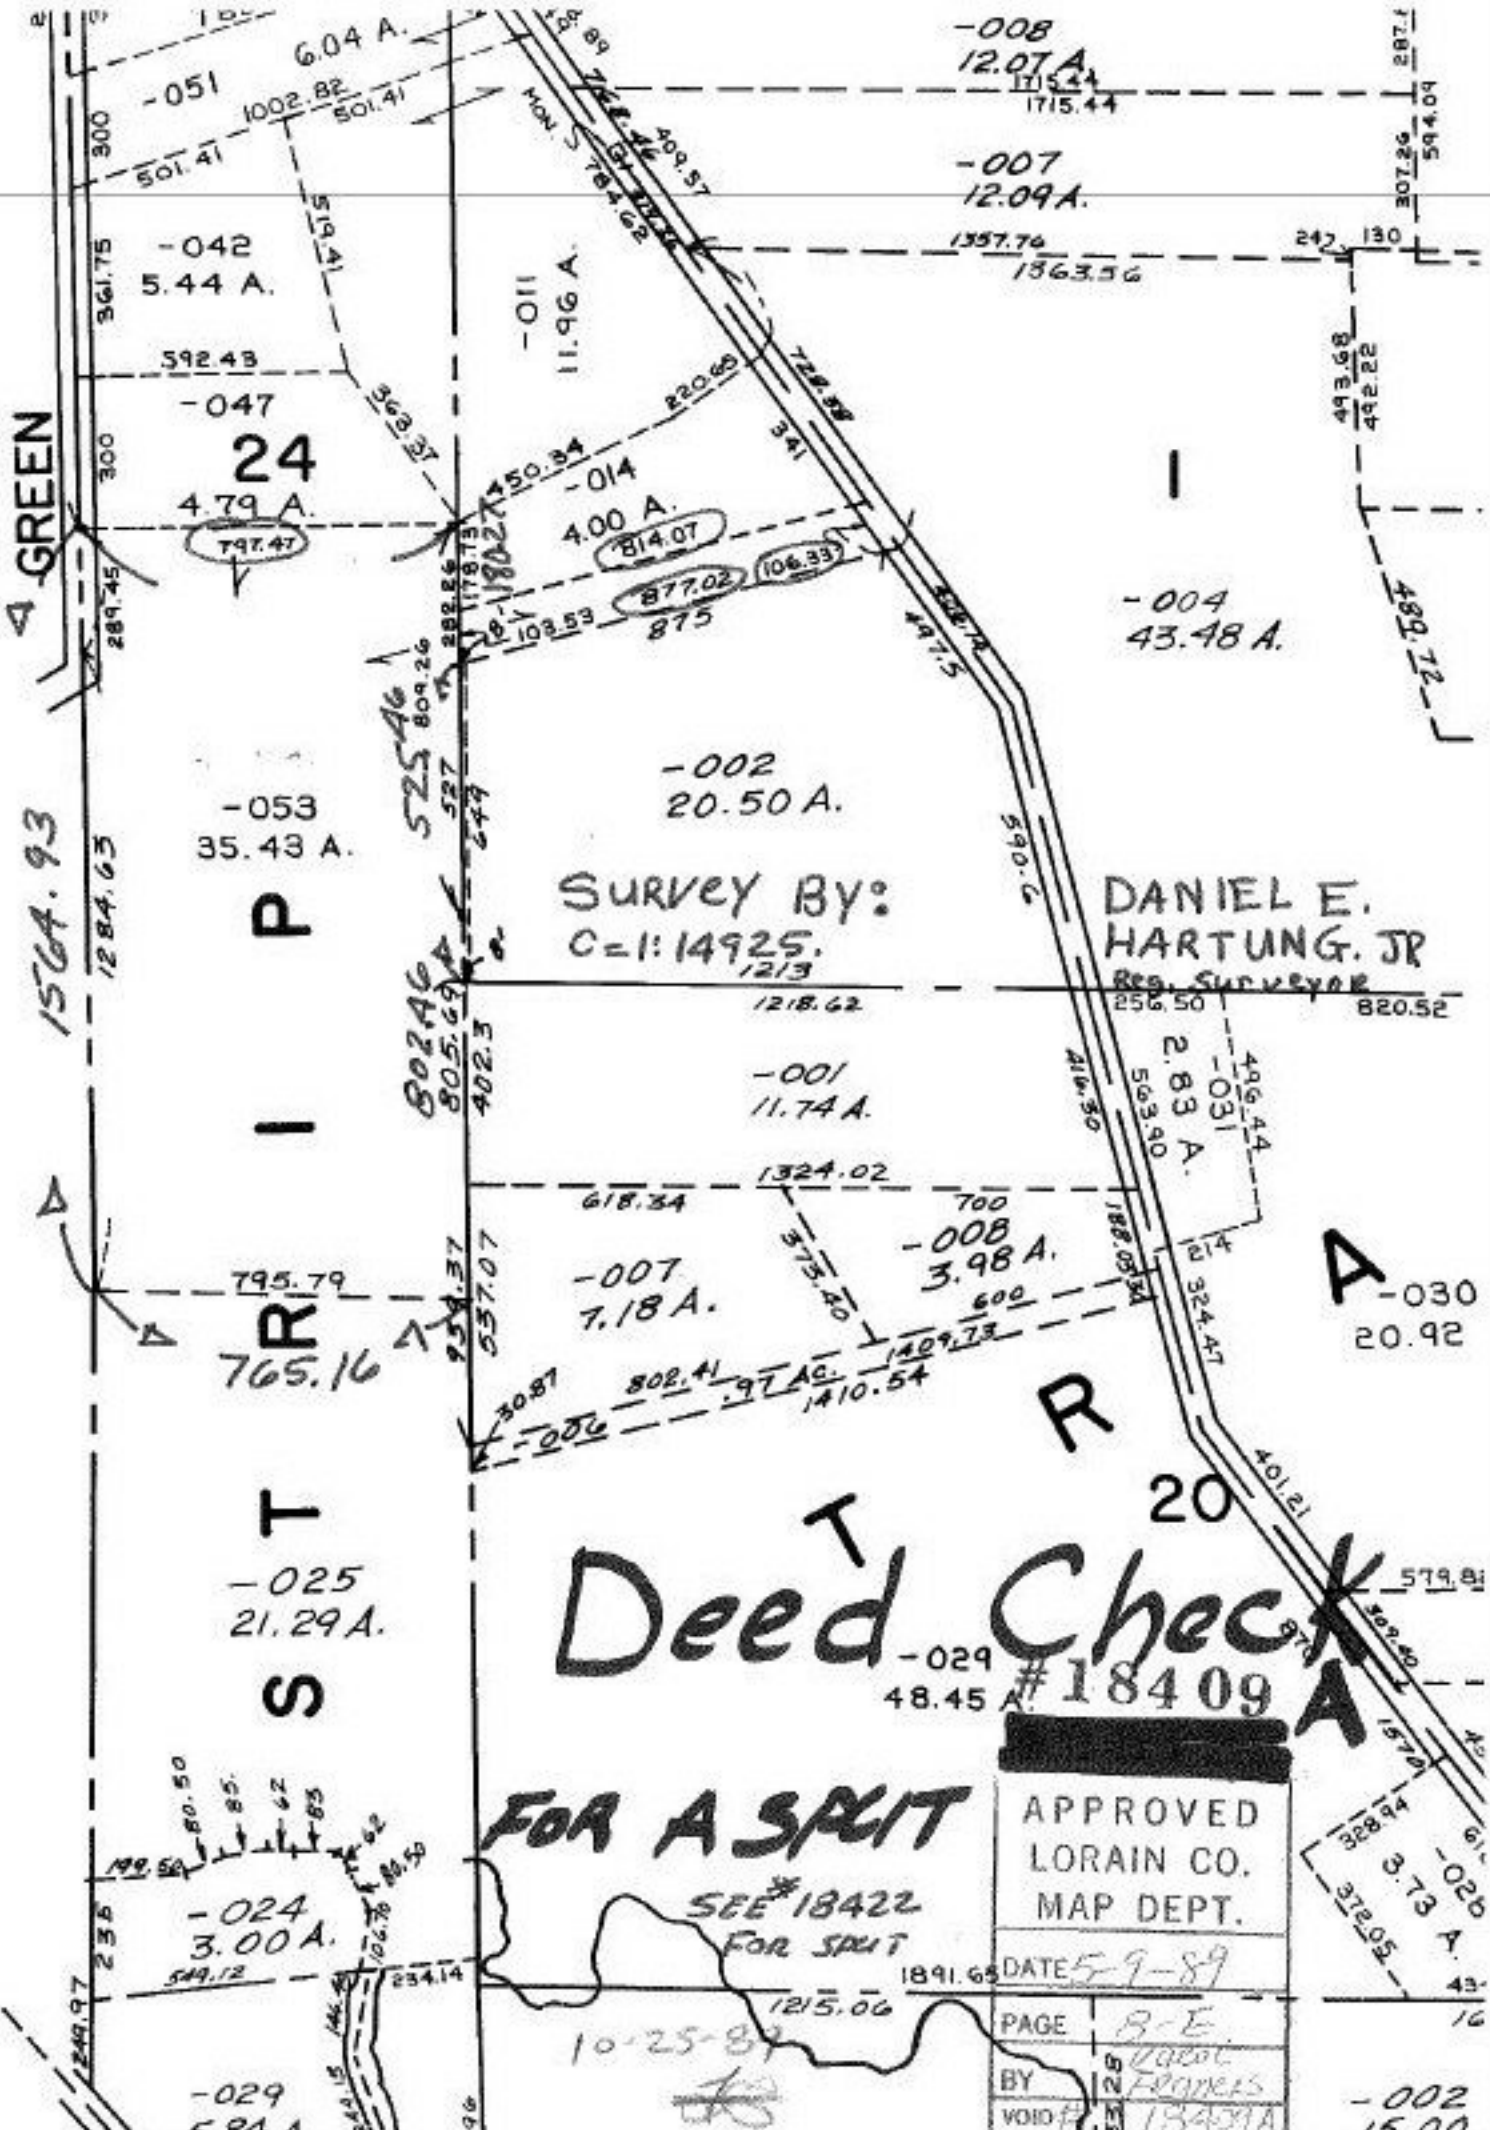

SURVEY BY:
C-1:14925.
12/3

DANIEL E. HARTUNG, JR.
Reg. Surveyor

Deed Check #18409

FOR A SPLIT

SEE #18422 FOR SPLIT

10-25-89

APPROVED
LORAIN CO.
MAP DEPT.

DATE 5-9-89

PAGE B-E

BY [Signature]
VOID # 18409A

-026 3.73 A.
-029 5.94 A.
-002 15.00