


SEE 11-00-018-A

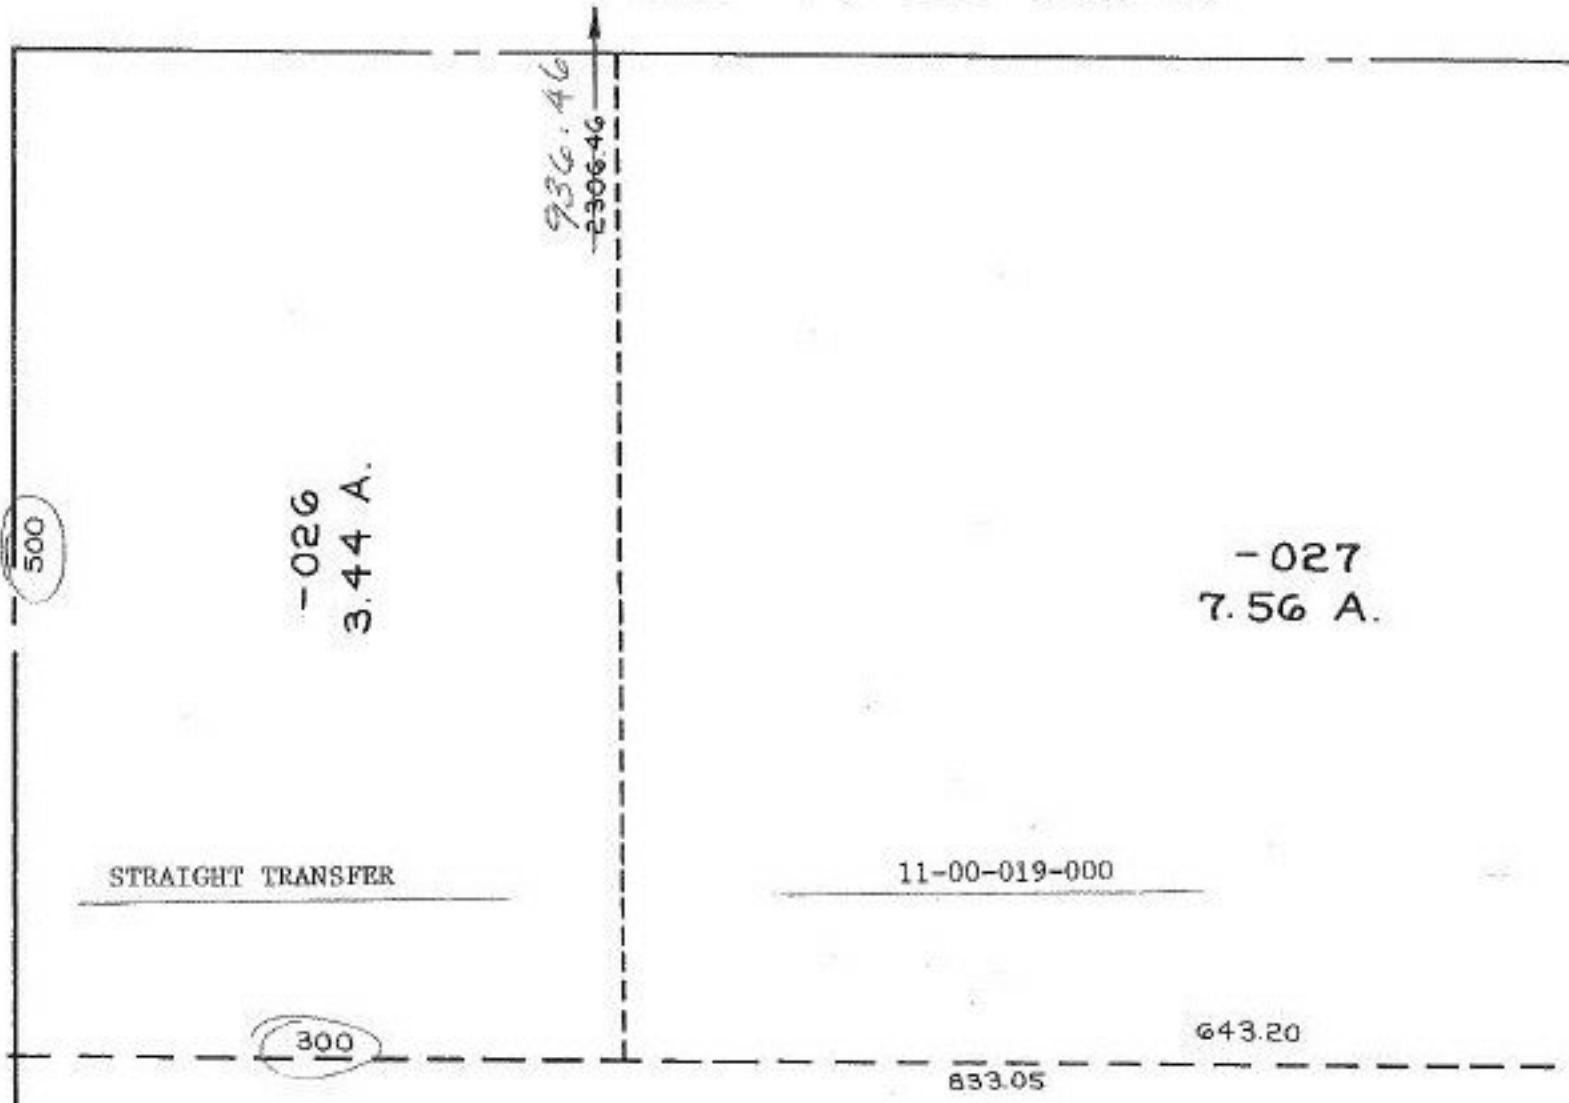

SA 8/4/89
#18410

APPROVED	
LORAIN CO.	
MAP DEPT.	
DATE 5-2-89	
PAGE 11-00-019-A	
BY CAROL FRANCIS	
VOID AFTER #	18410