


25.50 A.

Ac. Corr. per  
Survey by  
C=1:11NF  
Landon  
Simon  
C.A.H.L. Assoc.

GREEN

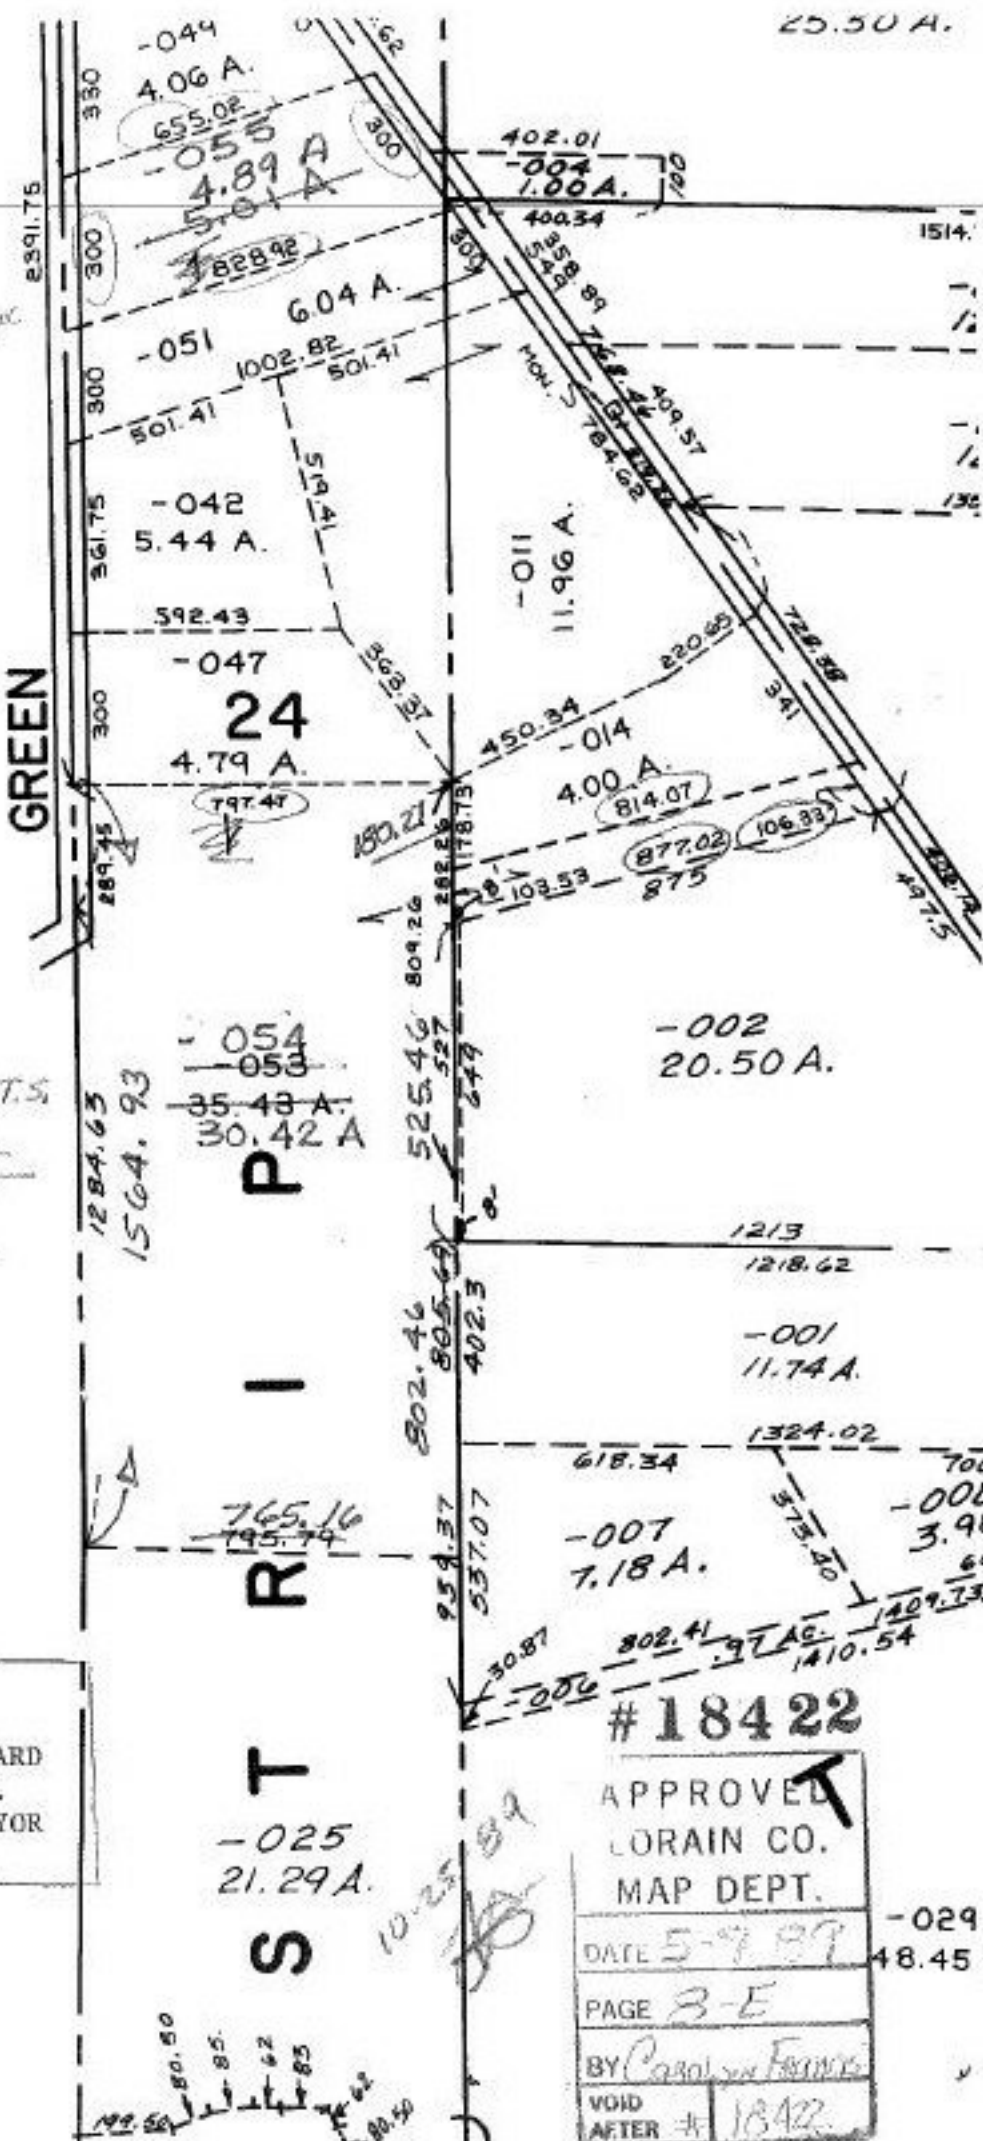

35.43 T.M.	35.429 T.S.
- 30.42	- 30.42
5.01	5.009
	5.01

08-20-024-000-  
PRIOR INST.  
DESC. FROM RECORD  
SURVEYED BY: DANIEL EDWARD HARTUNG JR.  
REG. SURVEYOR  
C=1:14925

#18422  
APPROVED  
LORAIN CO.  
MAP DEPT.  
DATE 5-9-87  
PAGE 3-E  
BY Carol M. Francis  
VOID AFTER # 18422

-029  
48.45