


1843



APPROVED
 LORAIN CO.
 MAP DEPT.
 DATE 6-8-68
 5-00-081
 BY *Hollert*

7-11-86 88

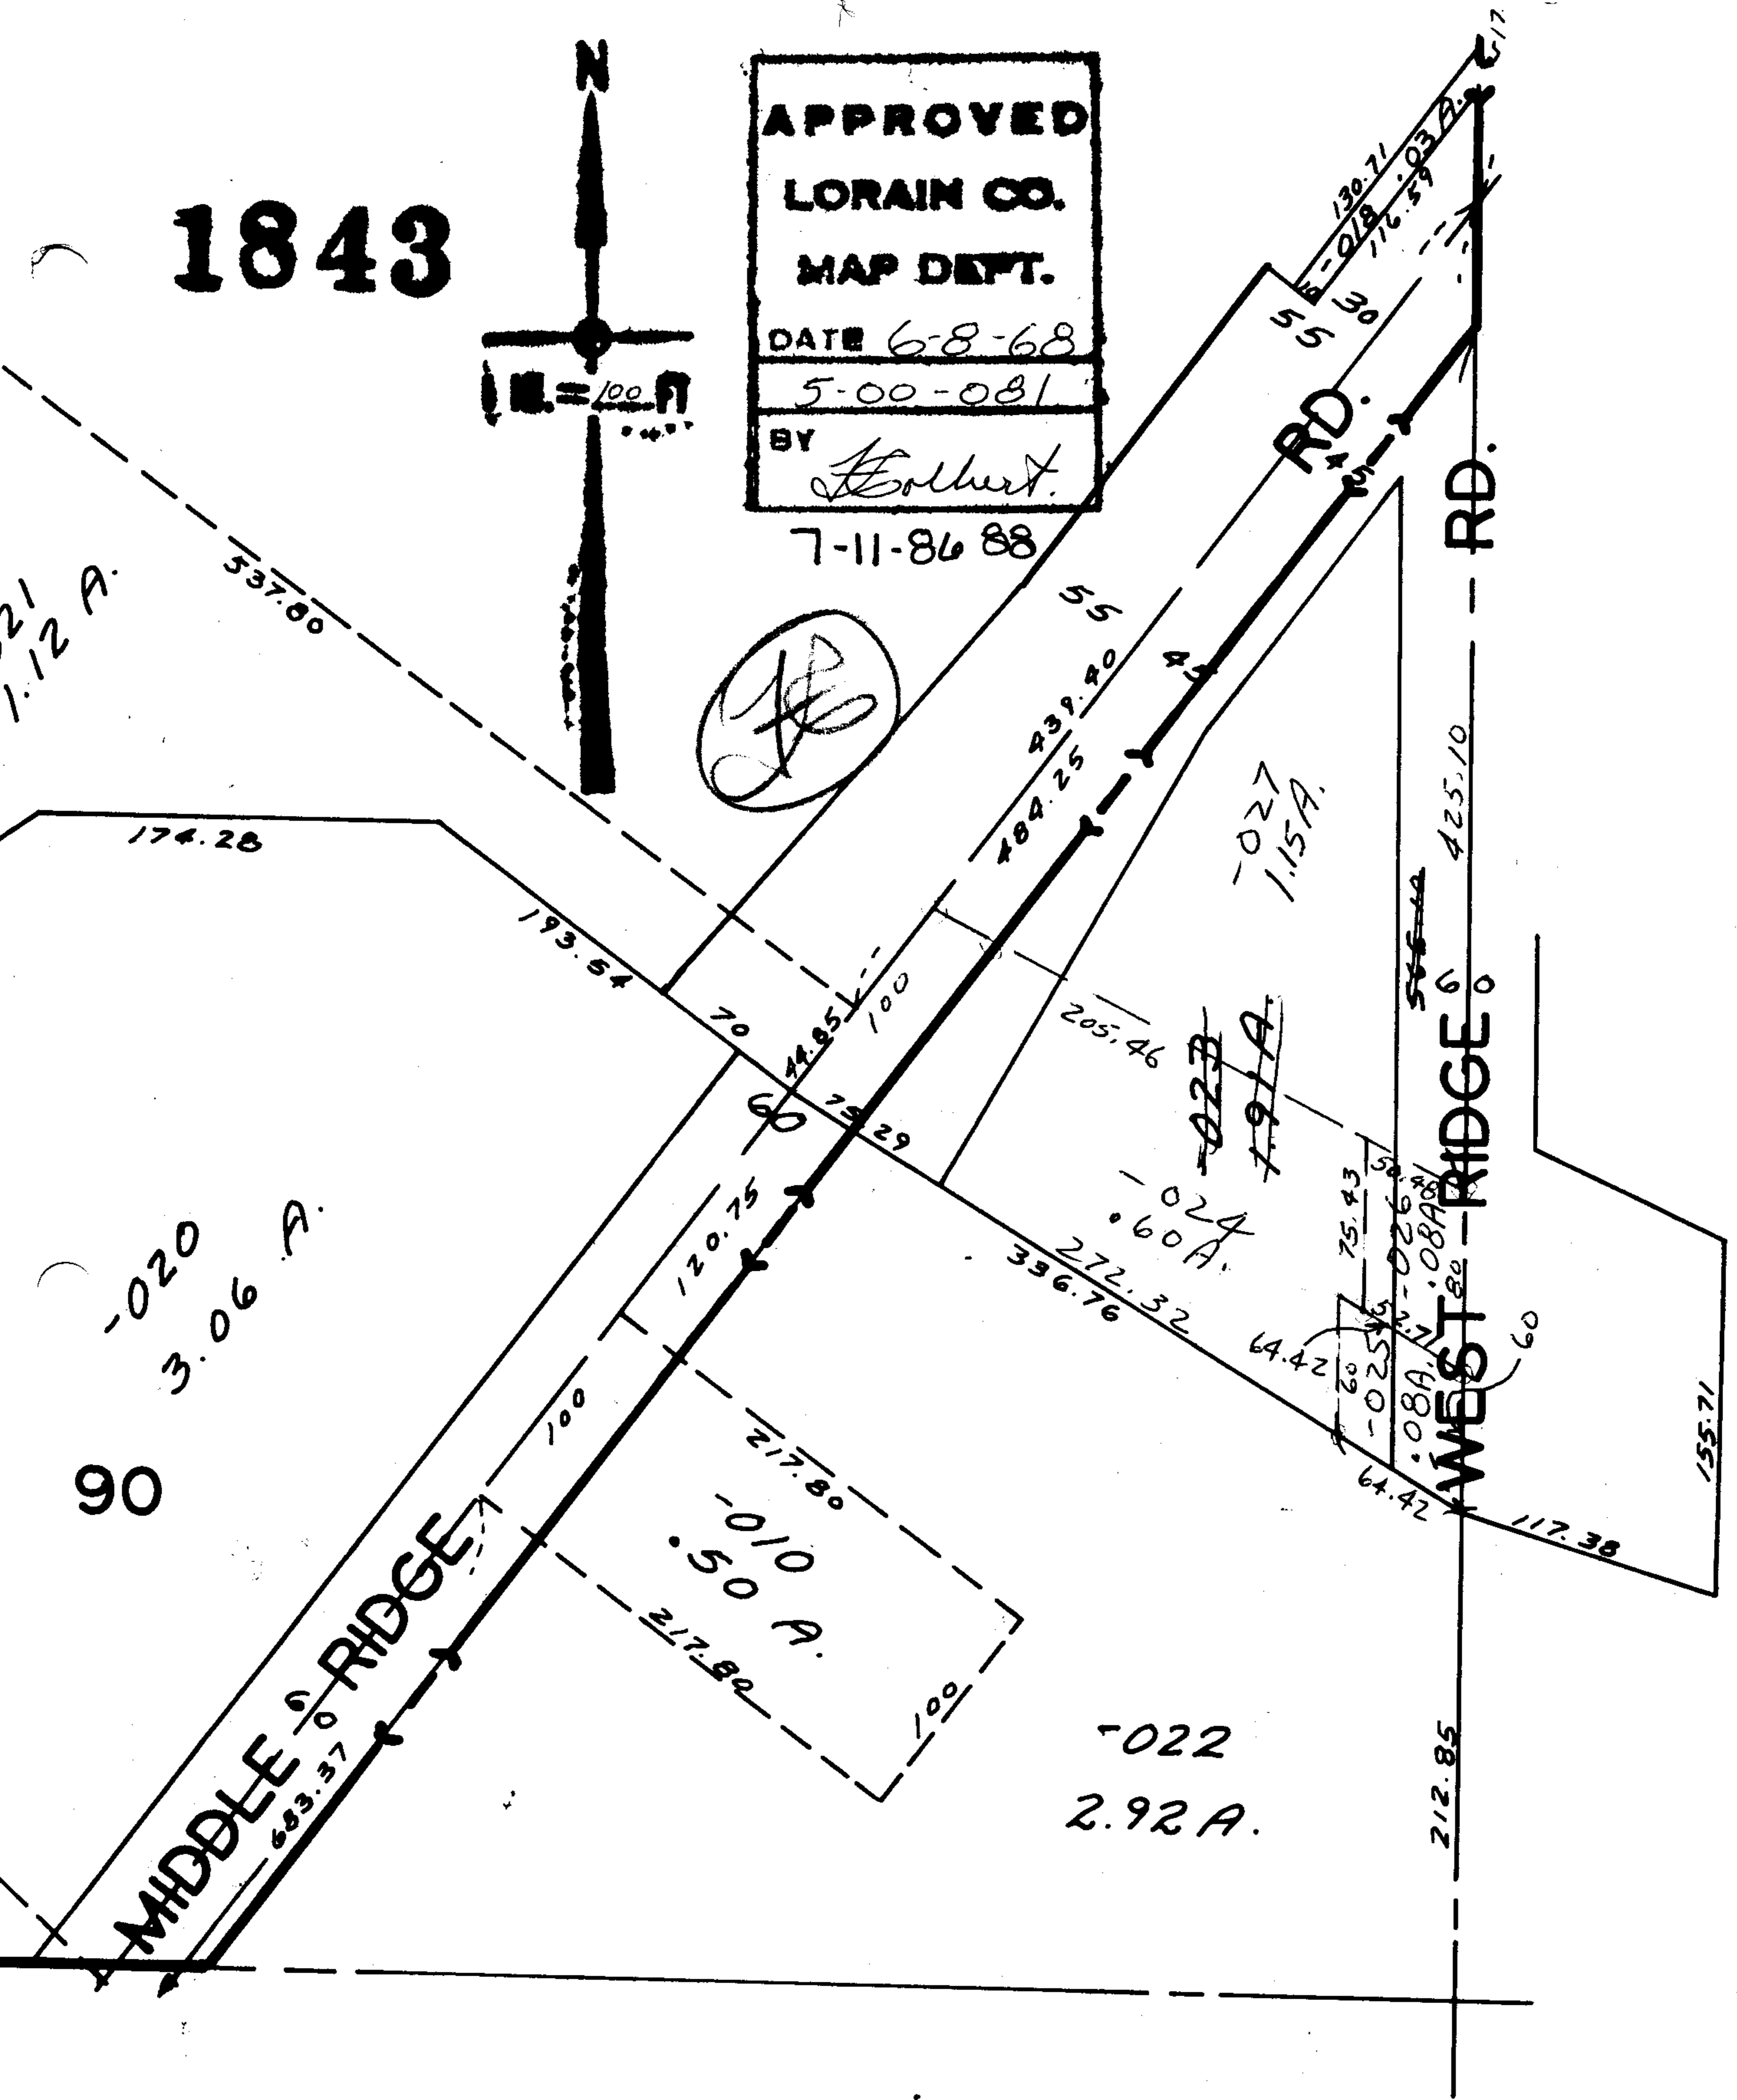

Done 7/19/68
Jim Thane

1843