


M. L.	S. L.
589.02	717.18
264.02	100.70
325.00	616.48

ED SMITEK SUB. NO. 2  
V 37 P 56

EVERGREEN DRIVE

DETAIL  
589.02  
264.02  
-001

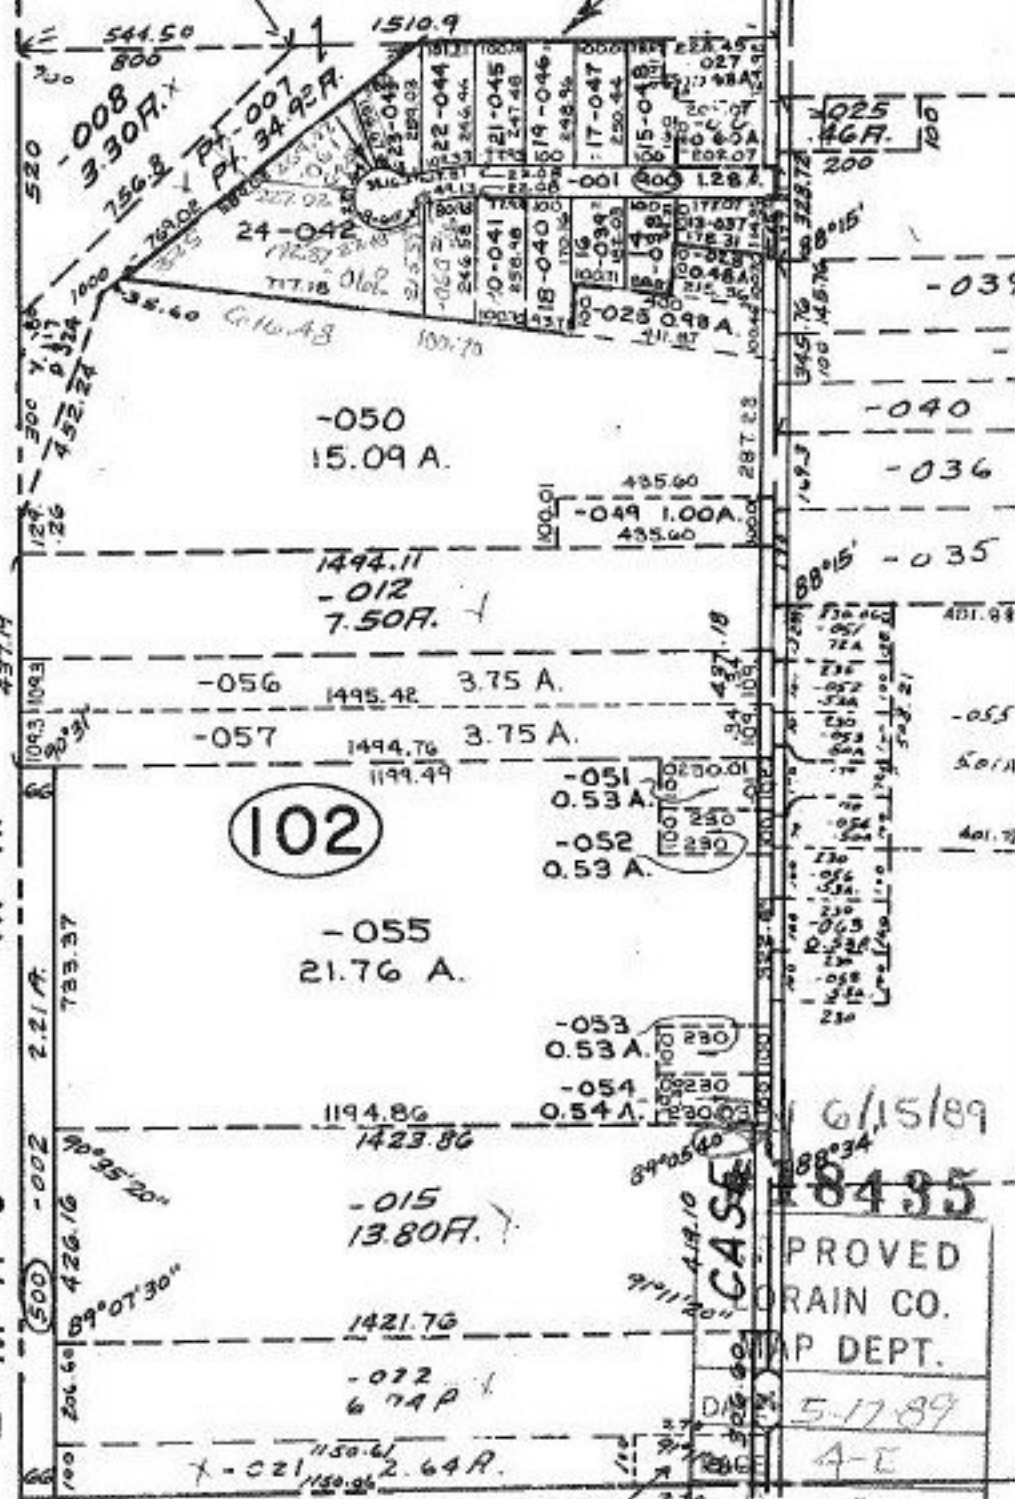

-042 307.42 X 246.58  
Deed A 102.63 X 246.58  
Deed B 64.25 X 227.02  
Deed C 192.87 X 215.59

Frontage P-A  
21.65  
80.98  
102.63

Frontage P-B  
229.64  
165.39  
64.25 Arc.

Frontage Rem: 165.39  
+ 87.48

PARCEL  
GIVEN A = 64.25  
R = 60  
CALC  
CH = 61.22  
Δ = 61.21 - 15.23  
CB = 27.48

289.64  
49.13  
- 21.65 Deed  
27.48 Rem.

R. R.  
N. Y. C.

102

-051 0.53 A.  
-052 0.53 A.

-053 0.53 A.  
-054 0.54 A.

6/15/89  
8435  
PROVED  
RAIN CO.  
AP DEPT.  
5-17-89  
A-E  
BY Carol Franks  
VOID AFTER 1935