

R-006


23.62 A.

Put RR
ON
SPIKES
ON
MAP

-001
28.50 A.

579.82
230.00
447.82

16.41 = 0.15
5.39
11.02
Rel

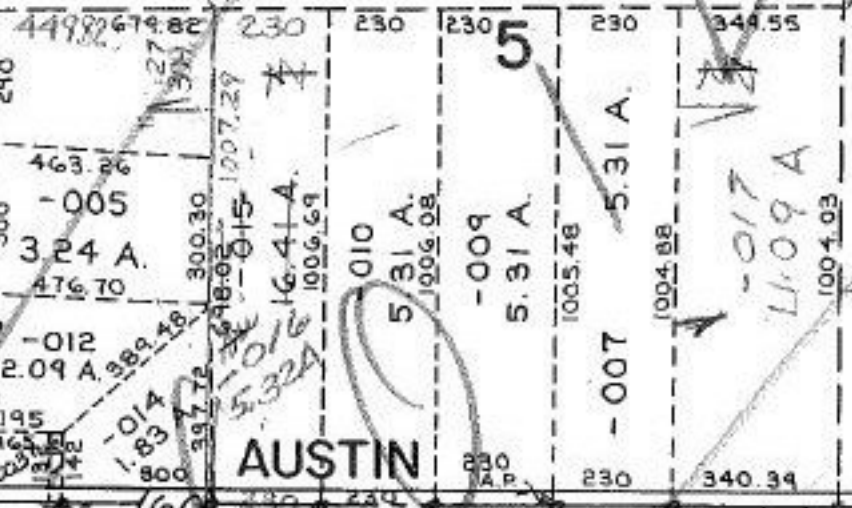

AUSTIN

13-08-005-000-
PRIOR INST. 820/367
SURVEYED BY: MICHAEL G. HURA
C=1: 1000000. REG. SURVEYOR

ASHLAND - KIPTON

-001
60.29 A.

R-6-14-89

-002
10.71 A.

10/31/89
#18441

APPROVED
LORAIN CO.
MAP DEPT.
DATE 5-18-89
PAGE 13-G
BY Paul-Francois
VOID AFTER #18441

511

SEE 17 - C

TRACT 8 LOTS 5, 6, 13