


STATE ROUTE 53 LEAVITT RD. R/W IS 80' WIDE

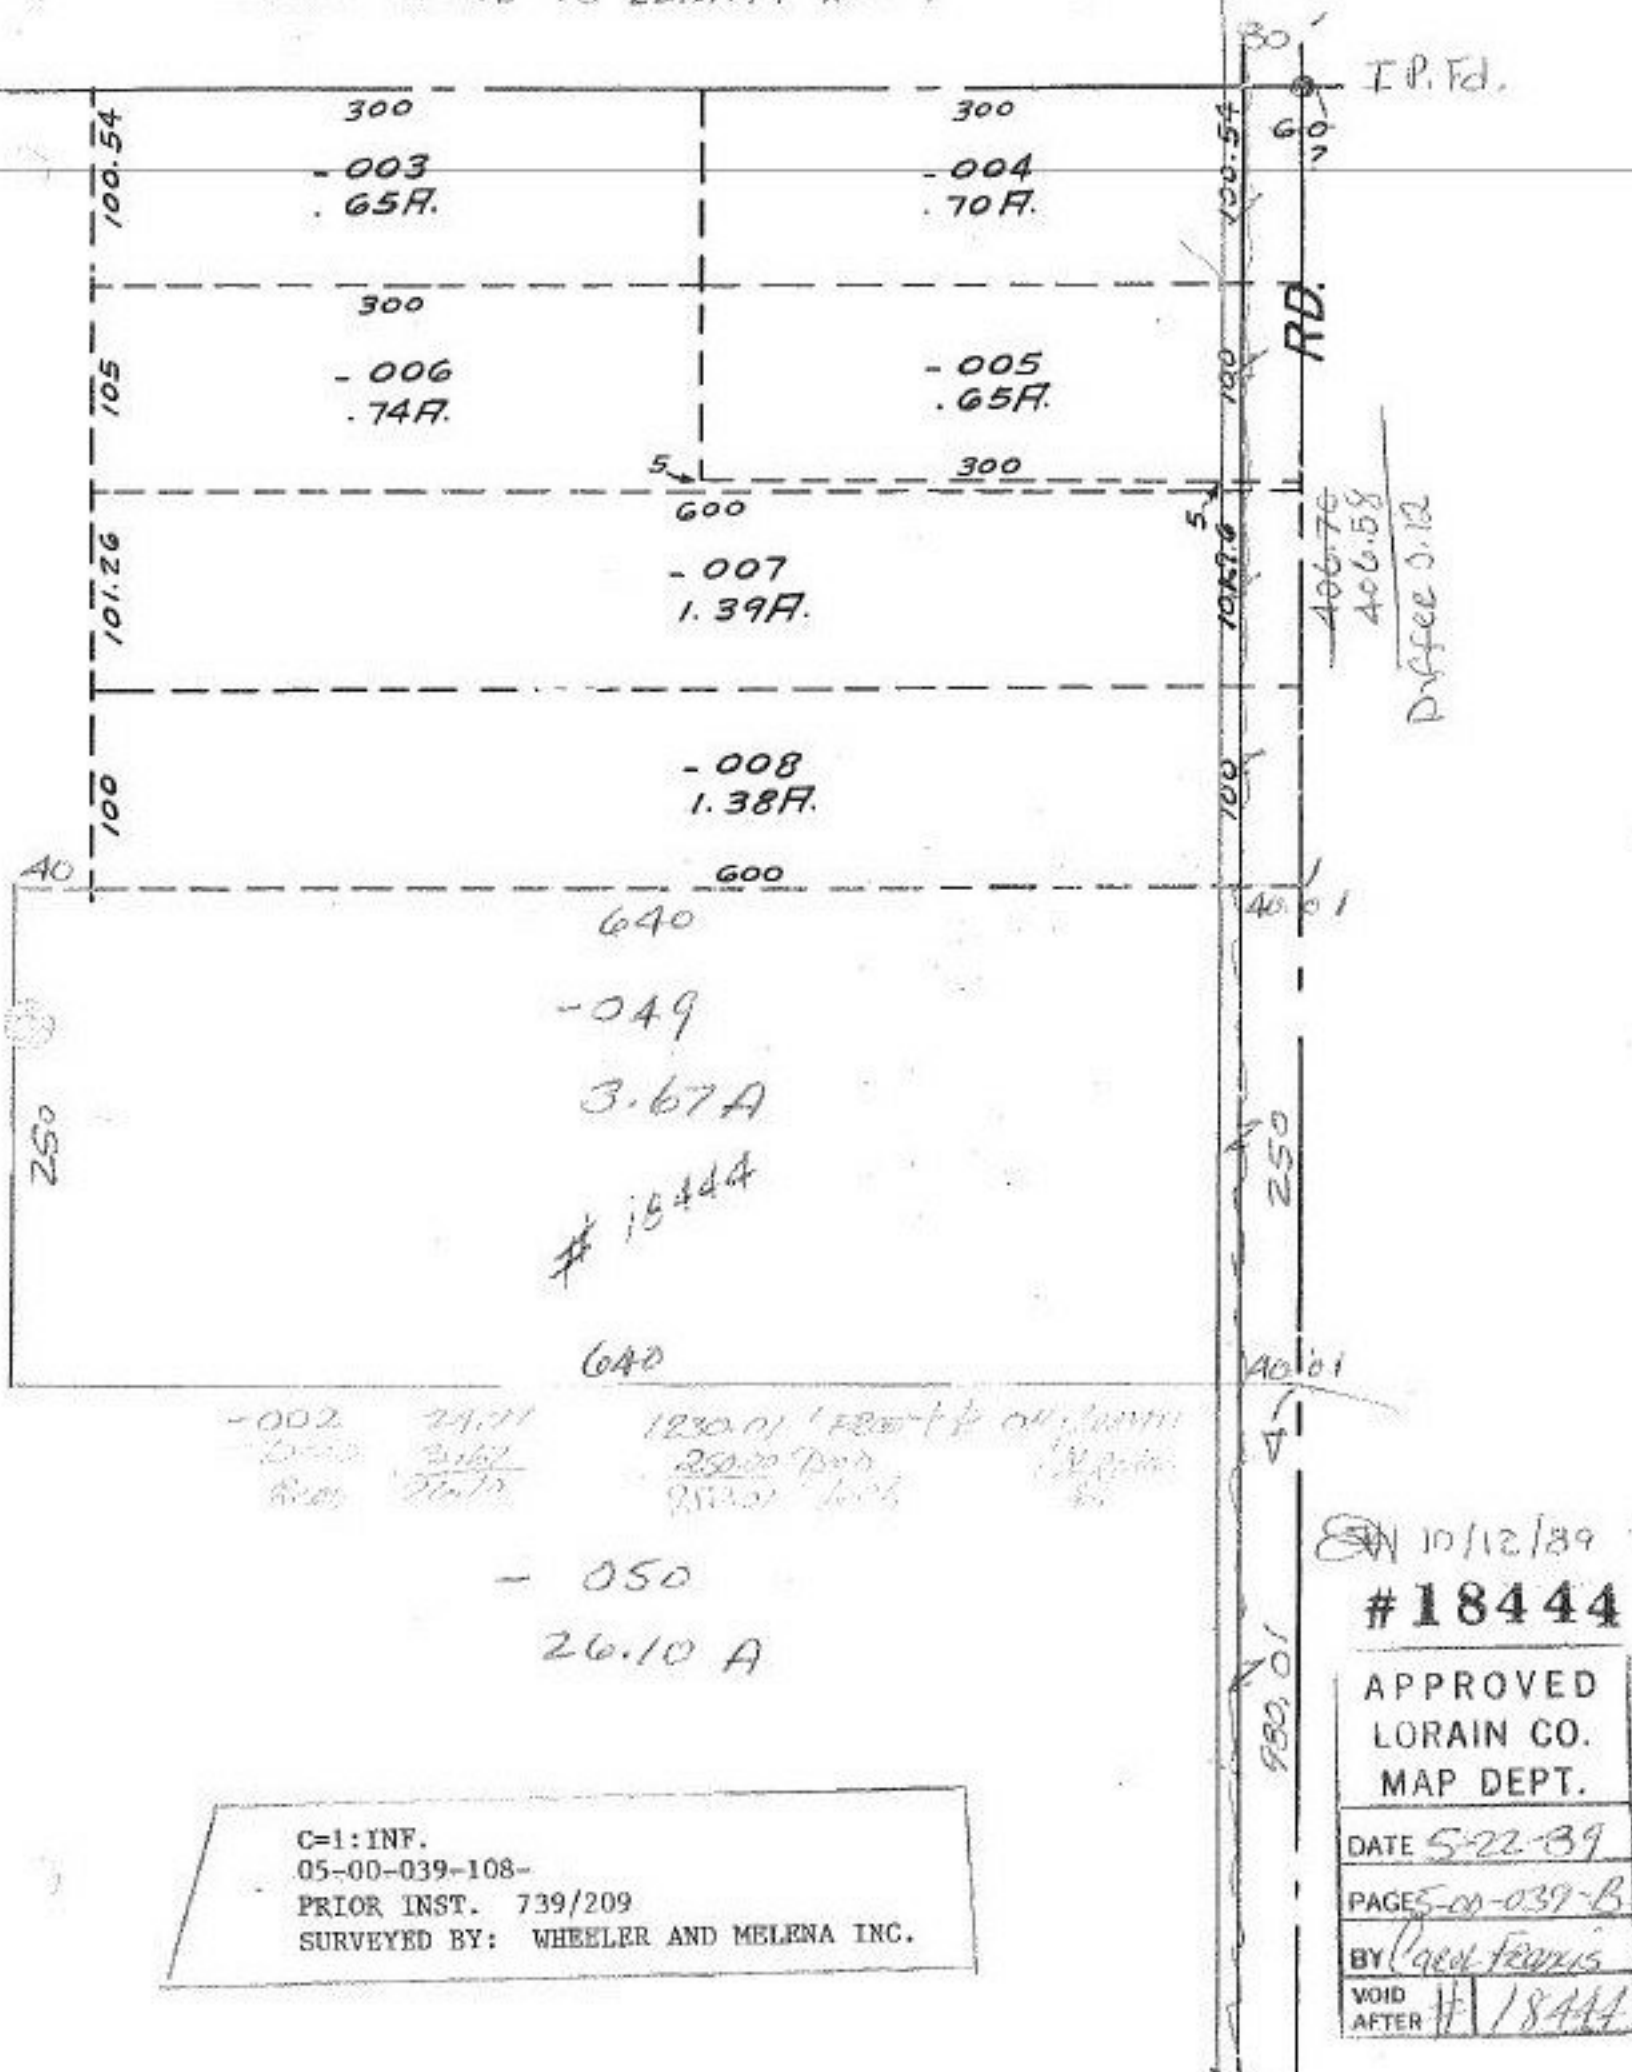

C=1:INF.
 05-00-039-108-
 PRIOR INST. 739/209
 SURVEYED BY: WHEELER AND MELINA INC.

SW 10/12/39
#18444
 APPROVED
 LORAIN CO.
 MAP DEPT.
 DATE 5-22-39
 PAGE 5-00-039-B
 BY *Paul Foxis*
 VOID AFTER # 18444