

698.28  
698.28  
668.28


-075. +84A

418.44

150

101.16


1846

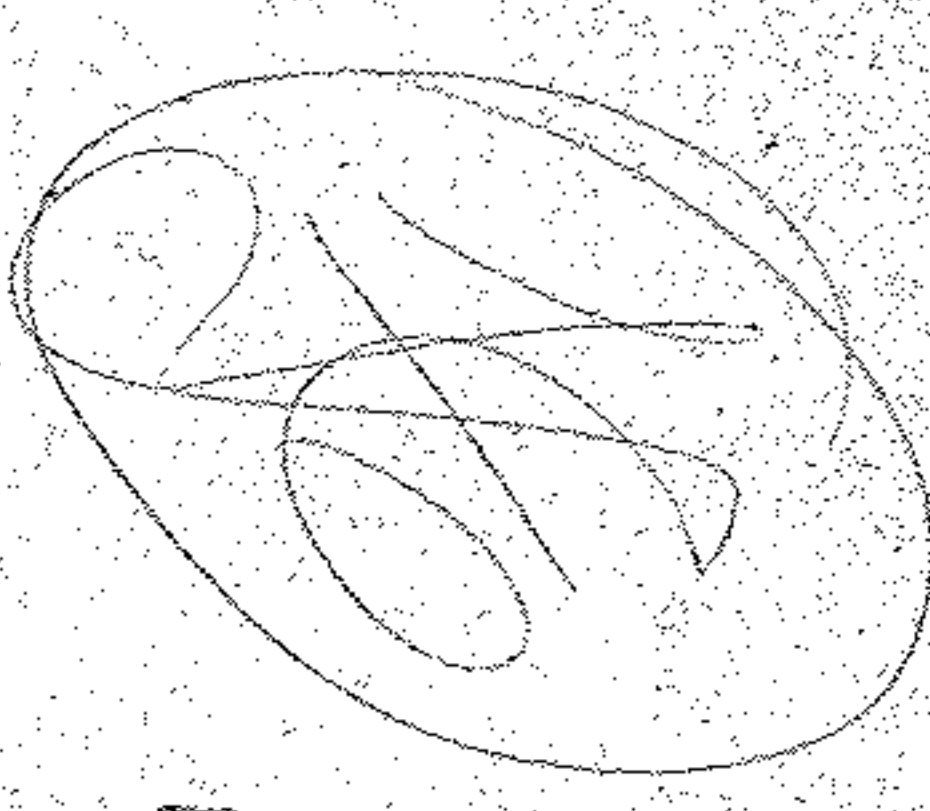

APPROVED
LORAIN CO.
MAP DEPT.
DATE 6-6-78
BY [Signature]

7-14-81 8.8

PR. -028  
PR. 34.11A.  
-076  
33.27 A.

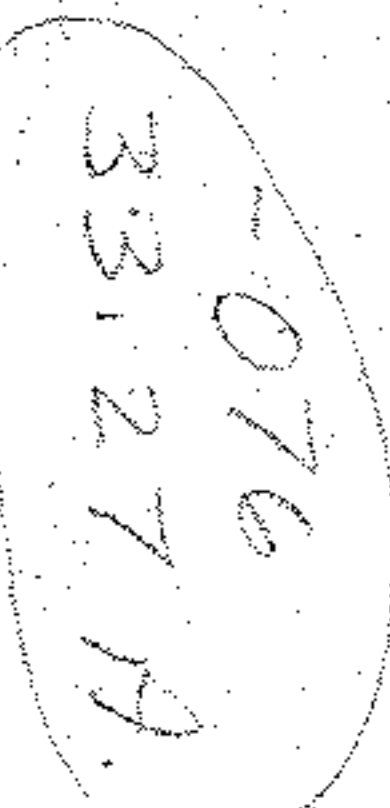

CHANGE PARCEL No.  
& ACRES PAGE 021-H  
PAGE 4-00



Done 8/68 M. Ross

218.72 R.D. 3

2137.72

3.4.84  
3.3.72