
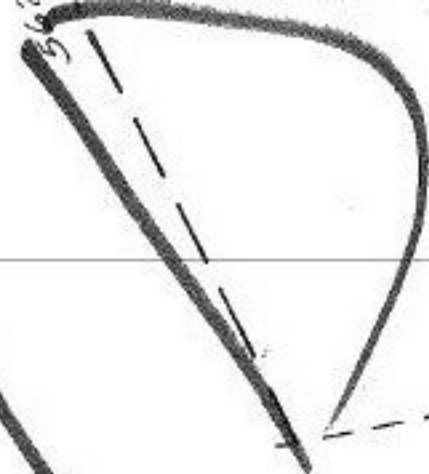


106

-077
9.70 A

Deed 0.09
0.09
0.09
0.09

137.13
137.13
137.13

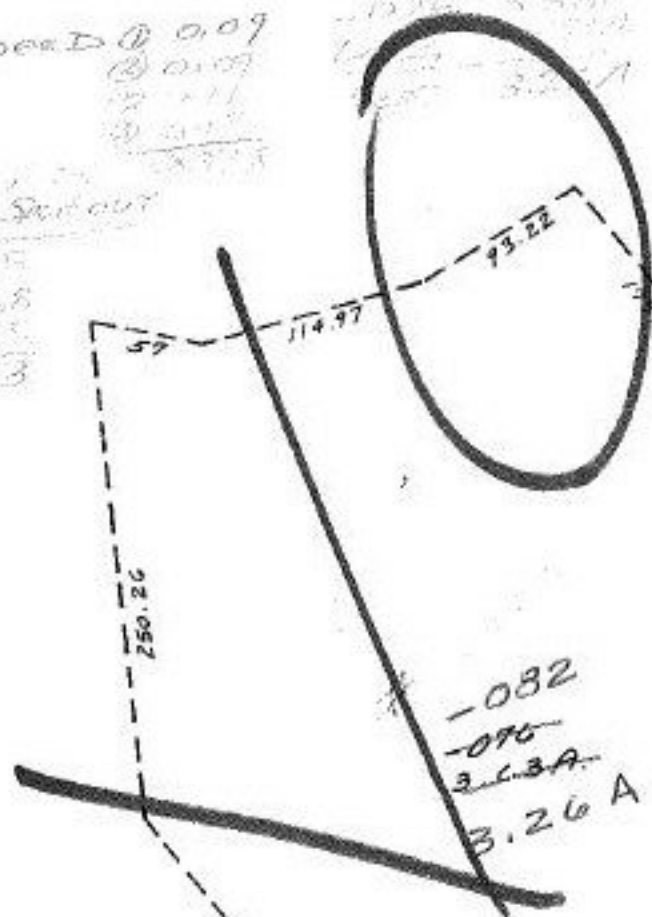

1654.90

05-00-059-106-
PRIOR INST. 1252/19
SURVEYED BY: KS ASSOC. INC.
(1) & (2) C-1: INF.
(3) C-1:76923 (4) C-1:62500.

1. P. Rd.

178-064

177-063

176-062

175-061

174-060

173-059

Handwritten notes and scribbles, including a large 'V' and '21-89'.

HIDDEN VALLEY

GRAYBARK BLOCK A

SUB

181.13

233.68

84

23-024

84

#18468

APPROVED
LORAIN CO
MAP DEPT.

DATE 6-12-89

PAGE 5

BY Carolyn Francis

VOID AFTER # 18468