

(143)

~~-054~~
~~39.26 A~~

COMBINATION

04-00-019-143-054
-059
-002
-050

-217
-282
51.51 A

-002 5.00
-050 4.86
-054 39.26
-059 4.39
51.51 A



SN 10/4/89
#18477A

APPROVED
LORAIN CO.
MAP DEPT.
DATE 6-14-89
PAGE 4-00-019-I
BY CAROL FRANCIS
VOID AFTER # 18477A

~~000~~
5.00 A

~~059~~
4.34 A

702.57
-050
2.86 A
702.59

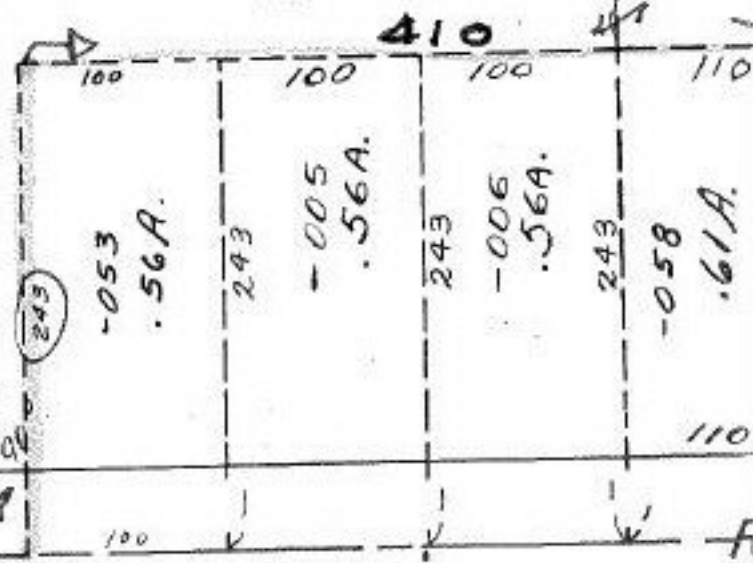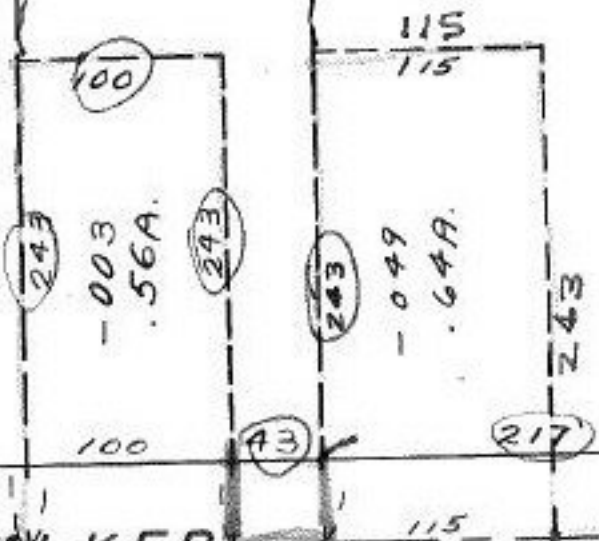

WALKER

SEE 4-C