

DISKING  
10 Place of  
Beginning

-052  
3.73 A.

101

WEST LINE  
332.44  
226.23 10.18  
72.71

Pt. 8.63A.

N. LINE  
2,211.97


S. LINE

EAST LINE  
356.47  
68.75 10.18  
159.50

157.50  
130.45

72.71  
30.11  
12.60  
6.20  
3.01  
35.60

03-00-07-101-  
PRIOR INST. 1090/840  
SURVEYED BY: JOHN R. HAMILTON  
C=1:125000, C=1:166666. REG. SURV

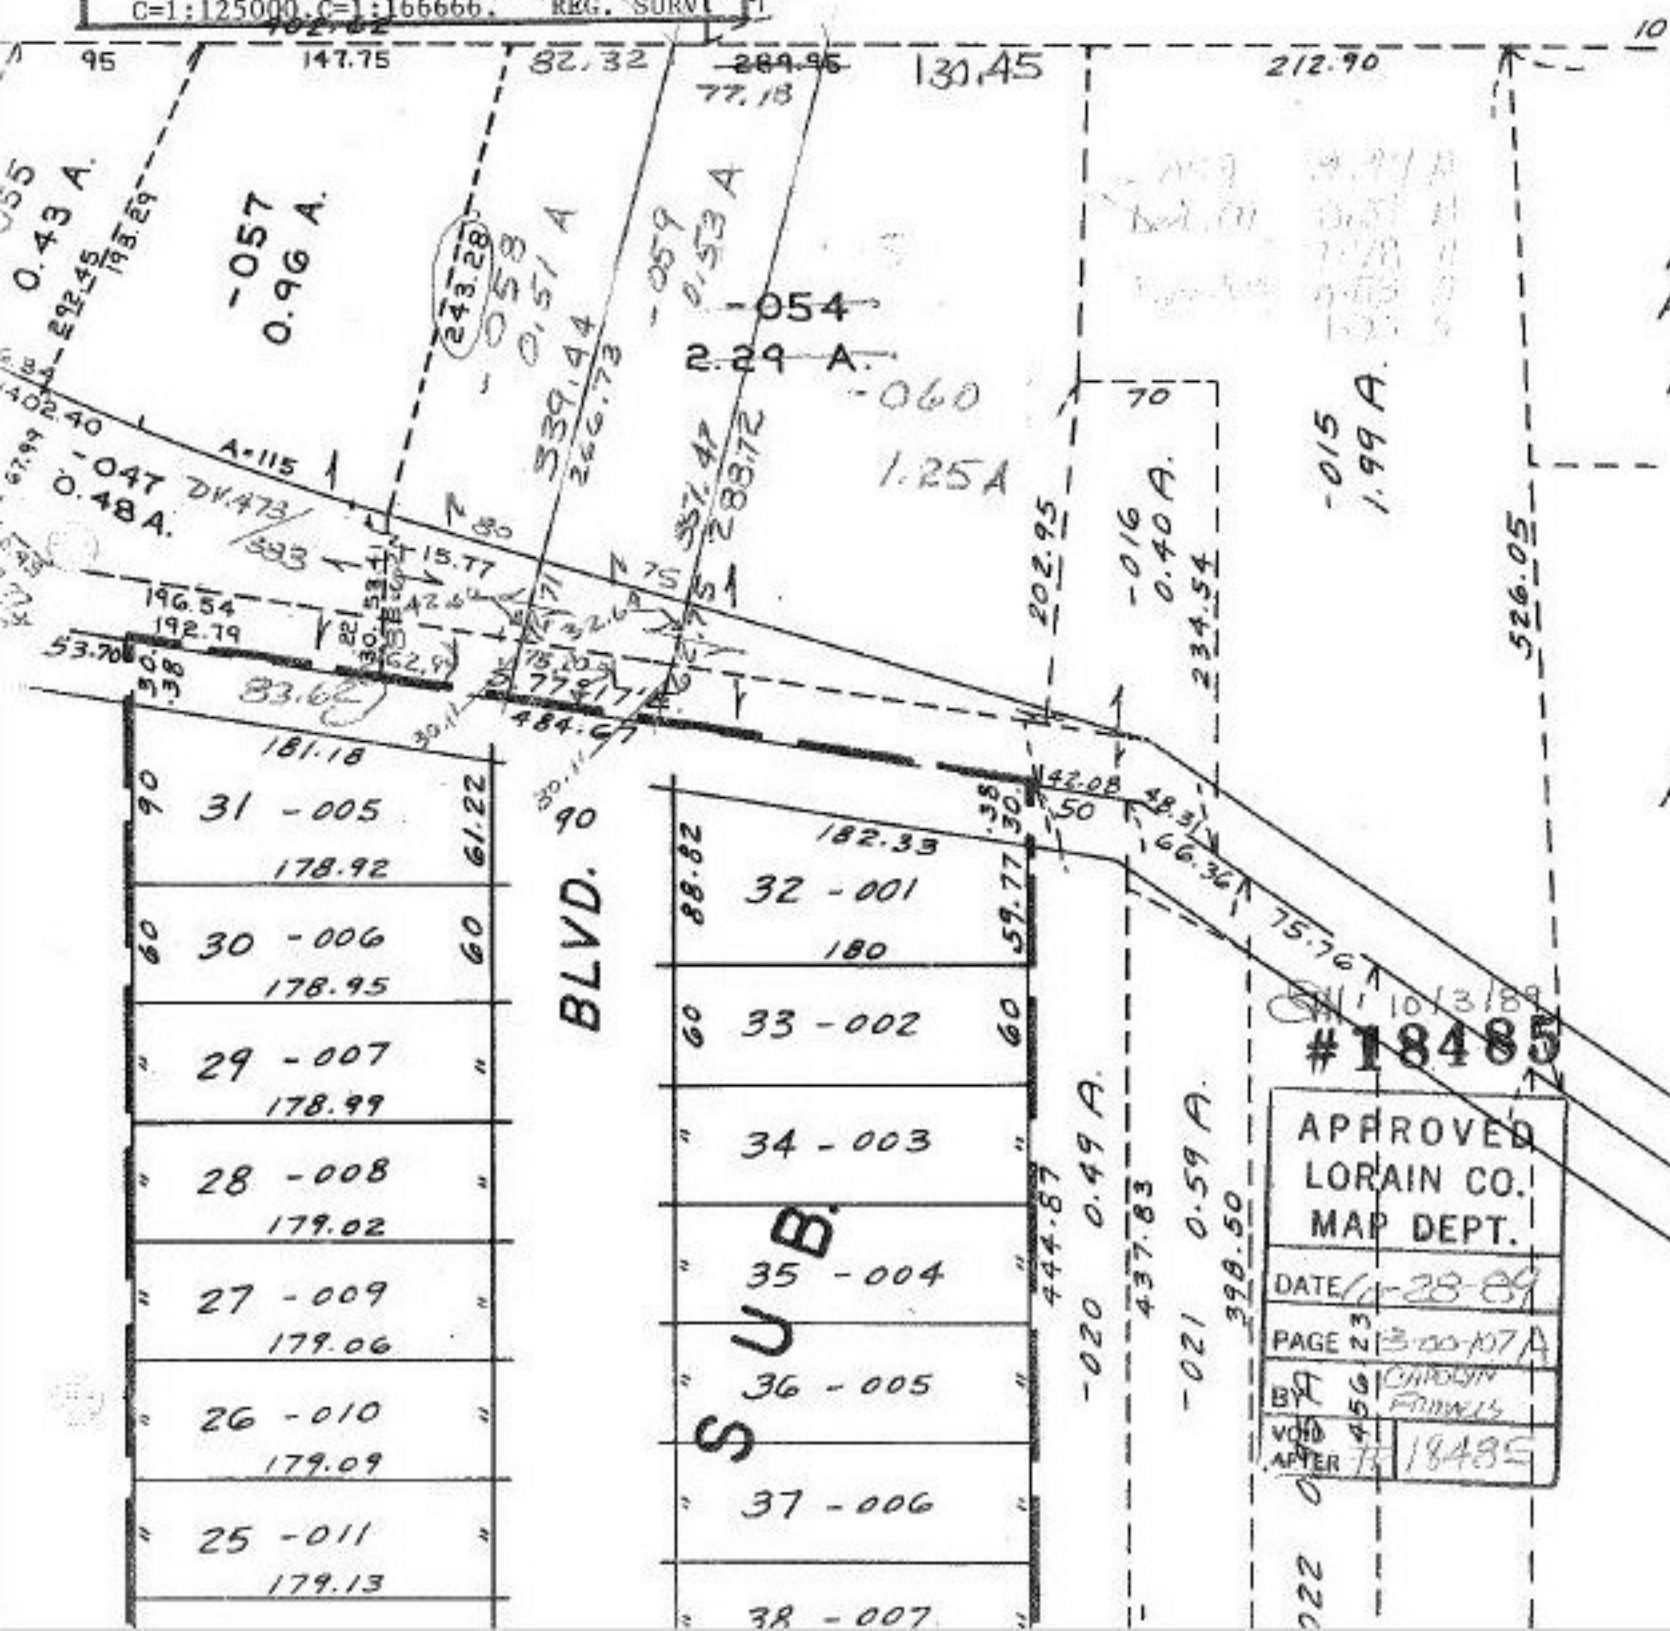

APPROVED  
LORAIN CO.  
MAP DEPT.  
DATE 10-28-89  
PAGE 23  
BY CAROLYN FRANKS  
NO. 18485  
AFTER 75