


79.80 30  
 TO + OAK POINT  
 N. LINE OIL 20  
 76.18  
 78.14  
 125  
 17-038  
 150  
 VOL 43  
 V-039  
 103.14  
 176.77  
 150.02  
 40.01  
 30.01  
 1609.40 TO C. OF COOPER FOSTER PARK RD  
 857.95  
 N. LAKE ST.  
 CITY

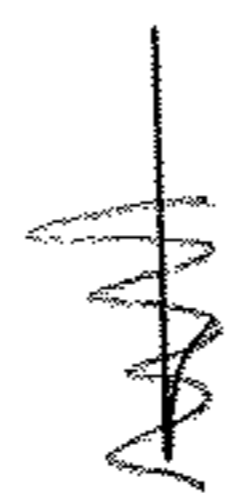

Pt. - 044  
 Pt. 26.71 A

1090.93

~~PT. - 040~~  
~~PT. 48.34 A.~~  
 21.63 A

-040 18.34  
 VOL 21.63  
 REF: 26.71

05-00-020-000-  
 PRIOR INST. 1350/412  
 SURVEYED BY: RICHARD J. BILSKI,  
 OHIO PROFESSIONAL SURVEYOR  
 C=1:1000000.

10/12/89  
 #18490

APPROVED  
 LORAIN CO.  
 MAP DEPT.  
 DATE 6-20-89  
 PAGE 5-00-020 A  
 BY CAROLYN FRANCIS  
 VOID AFTER # 18490

1082.40

1051.18

876.52

24+8

1619.40