


4.  
3.1

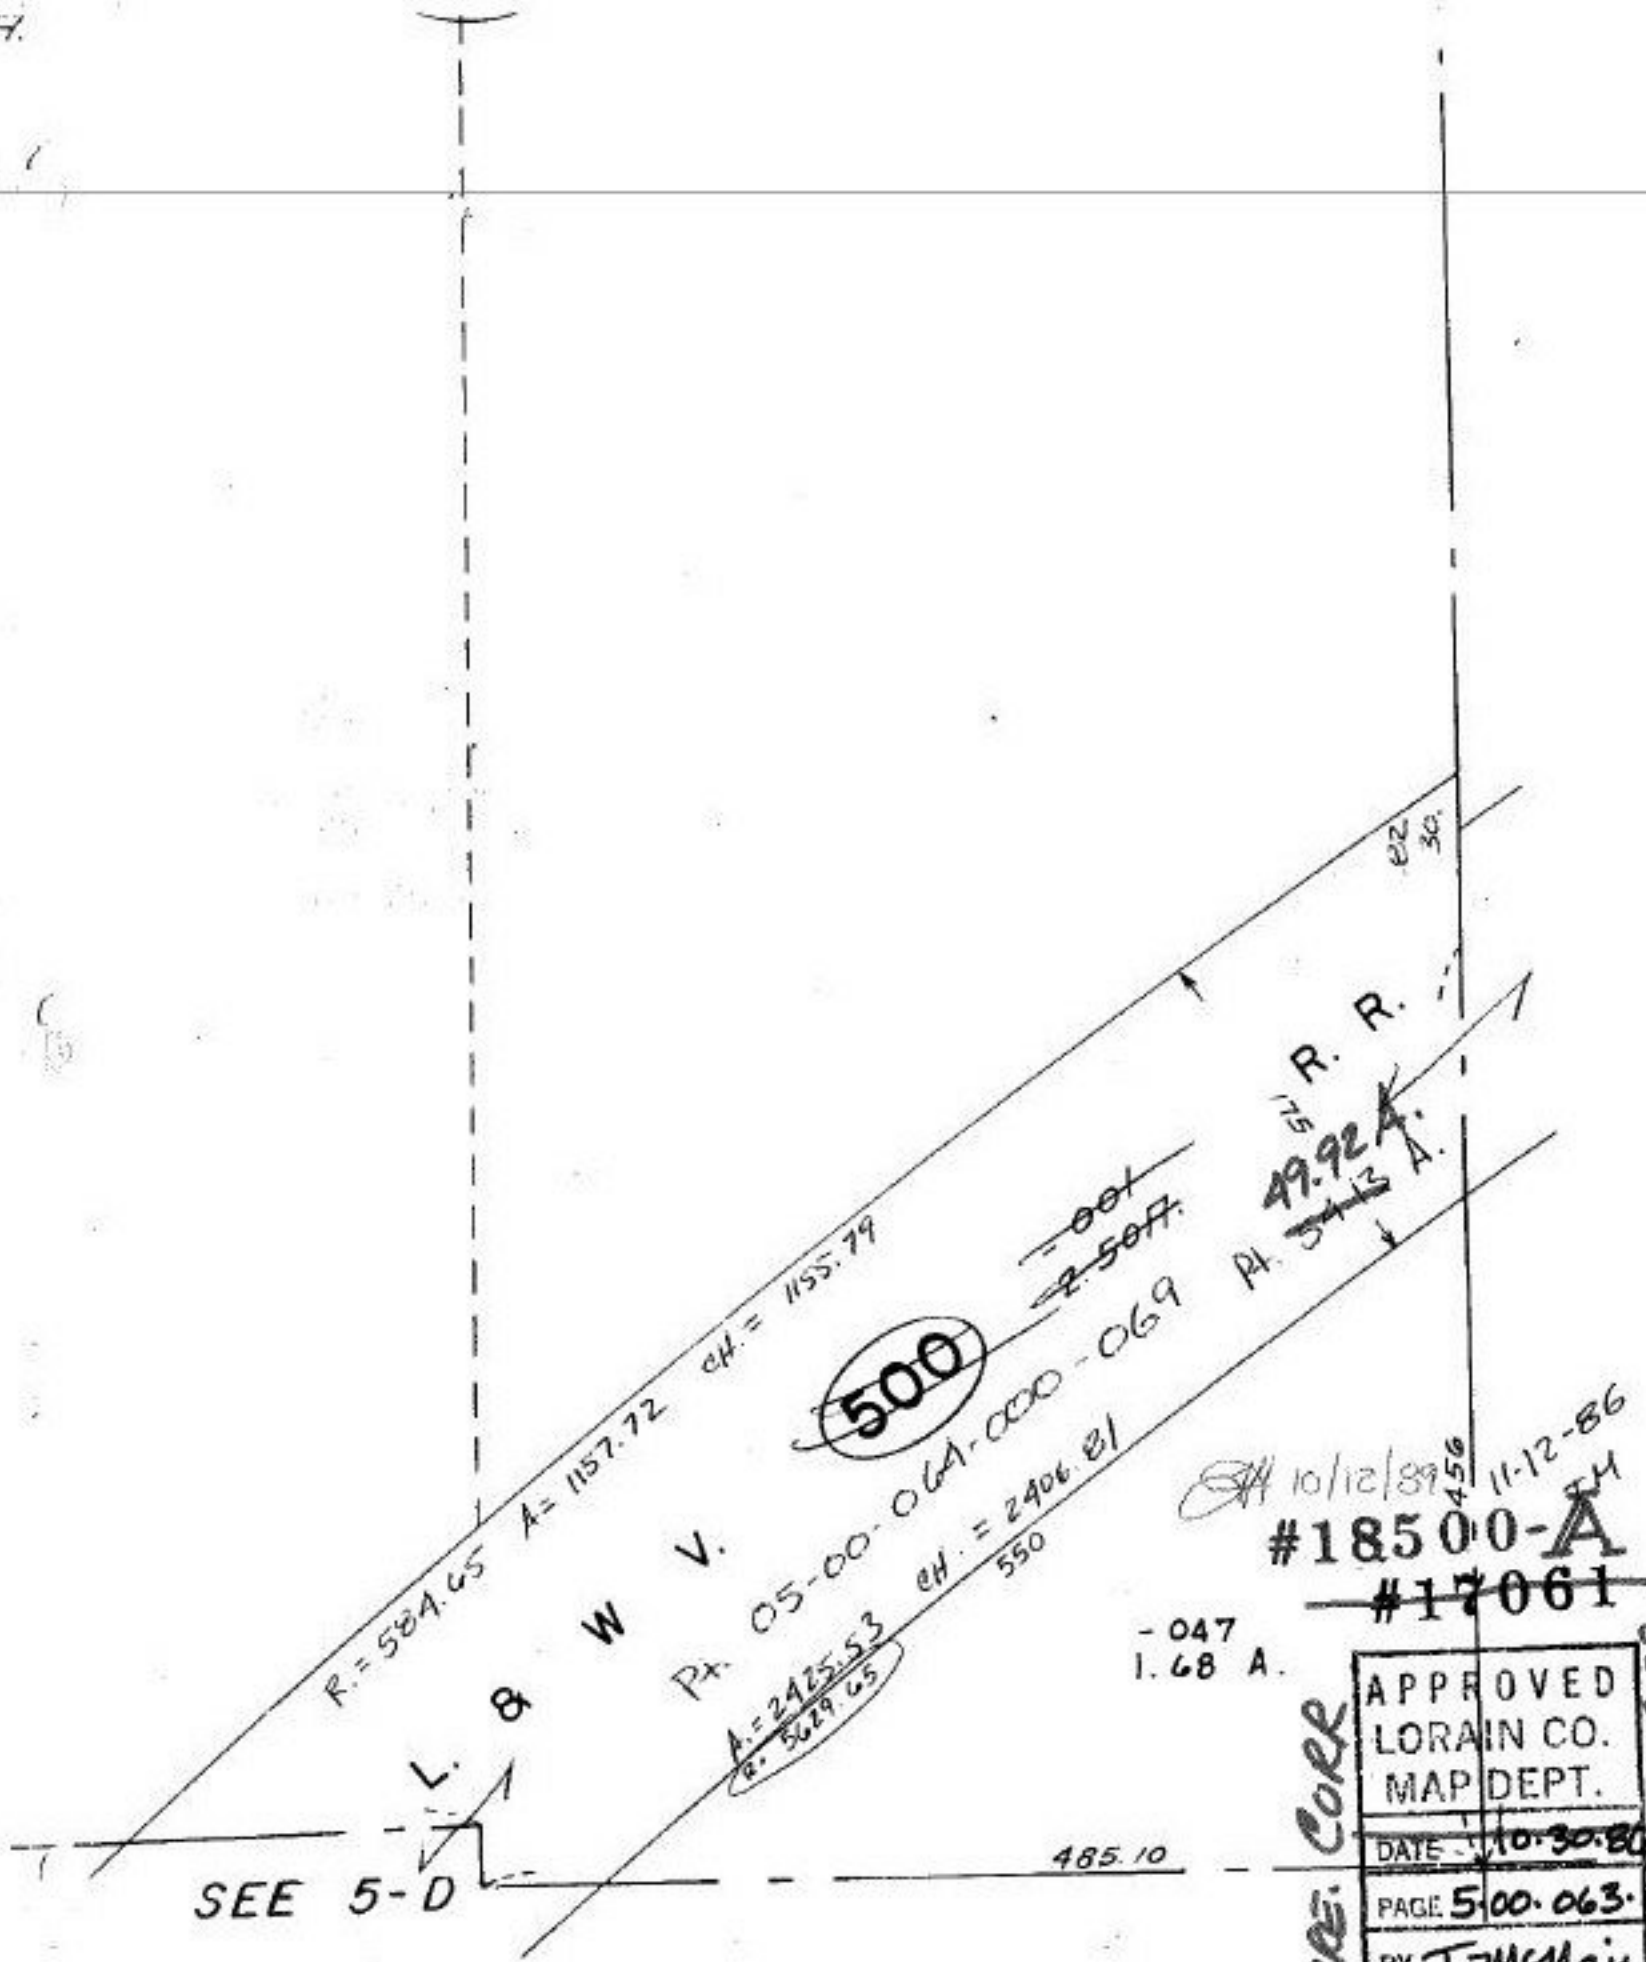

SEE 5-D

485.10

500

R.R.  
49.92 A.  
Pt. 3+13 A.

10/12/89  
 #18500-A  
 #17061  
 11-12-86  
 456  
 550

- 047  
1.68 A.

Acce. Corp.

APPROVED	
LORAIN CO.	
MAP DEPT.	
DATE	10-30-89
PAGE	5.00.063-B
BY	T. McHain
VOID AFTER	

5.00.063-B